

**Certificate  
of Survey**

From the office of  
**GEORGI-SCHMIDT & ASSOC. INC.**  
 3092 No. Lexington Ave., Roseville, Mn. 55113  
 LAND SURVEYING  
 483-4408

I Hereby Certify that this plat shows a survey made by me of the property described on this plat, and that the corners are correctly placed as shown, and that all locations have been correctly shown.

Job Number: 460

Surveyed For Carroll Story



Date Aug 29, 1979

Scale 1" = 40'

By Donald W. Schmidt  
 REGISTERED LAND SURVEYOR

Description:

The South 80.0 feet of the North 187.0 feet of Lot 1, Block 2, W.F. Krech's Add, Ramsey County, Minnesota.

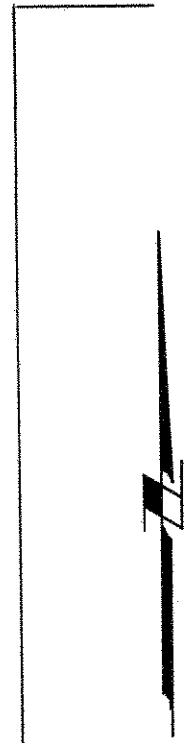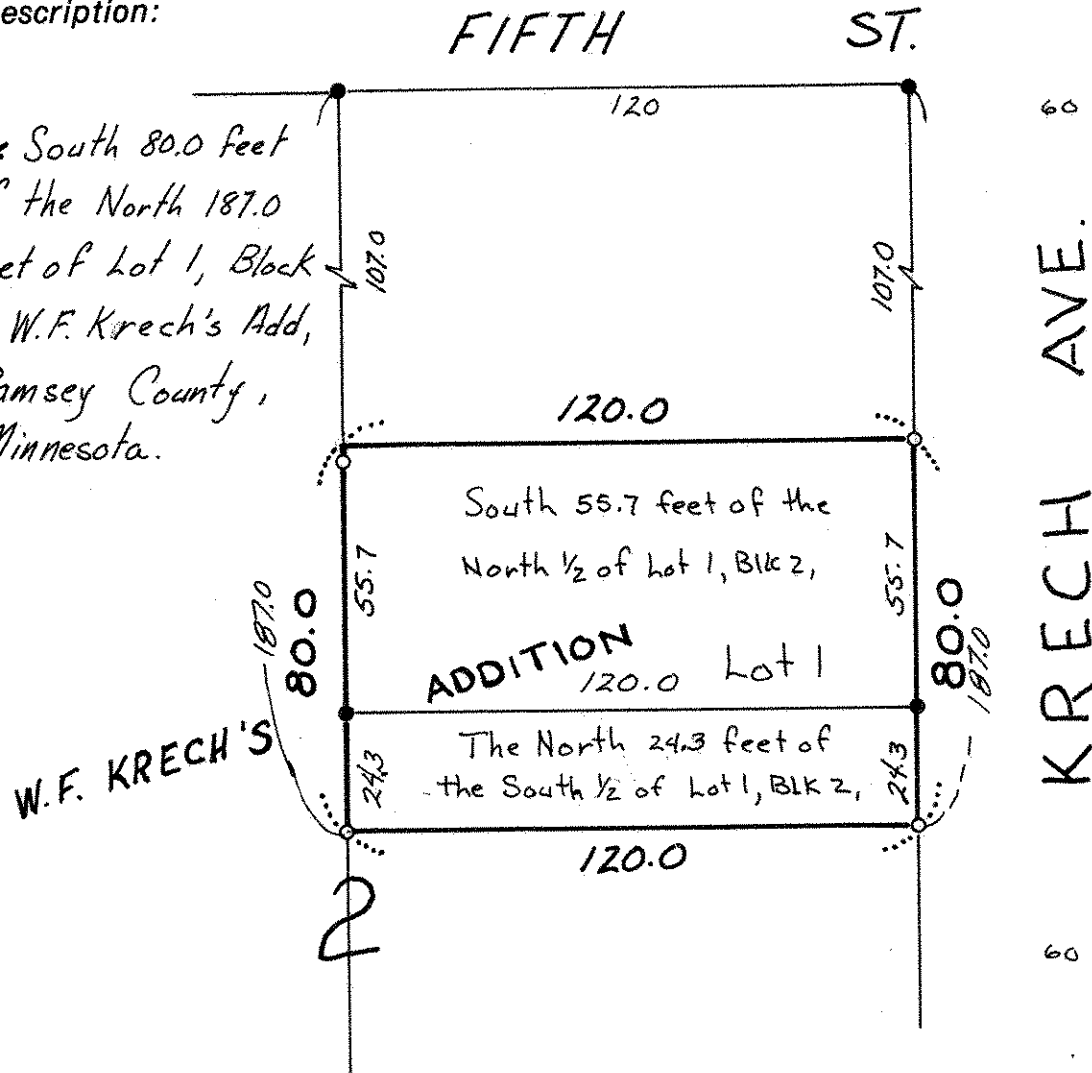

• Denotes iron pipe monument found in place  
 o Denotes iron pipe monument