NW 35 30 22

Certificate of Survey

From the office of

GEORGI- SCHMIDT & ASSOC. INC.

3092 No. Lexington Ave., Roseville, Mn. 55113

LAND SURVEYING

483-4408

I Hereby Certify that this plat shows a survey made by me of the property described on this plat, and that the corners are correctly placed as shown, and that all locations have been correctly shown.

Job Number: 296

Surveyed For Esther Palm

Date May 1979

Scale 1"=60'

By Donald W. Schmidt

REGISTERED LAND SURVEYOR

Description:

That part of the East ½ of Lot 11, Elmwood Garden Farms lying Southerly of the North 375 feet thereof and Northerly of a line run 30 feet NW'ly of and parallel to the following described Centerline of a 60 foot roadway and utility easement:

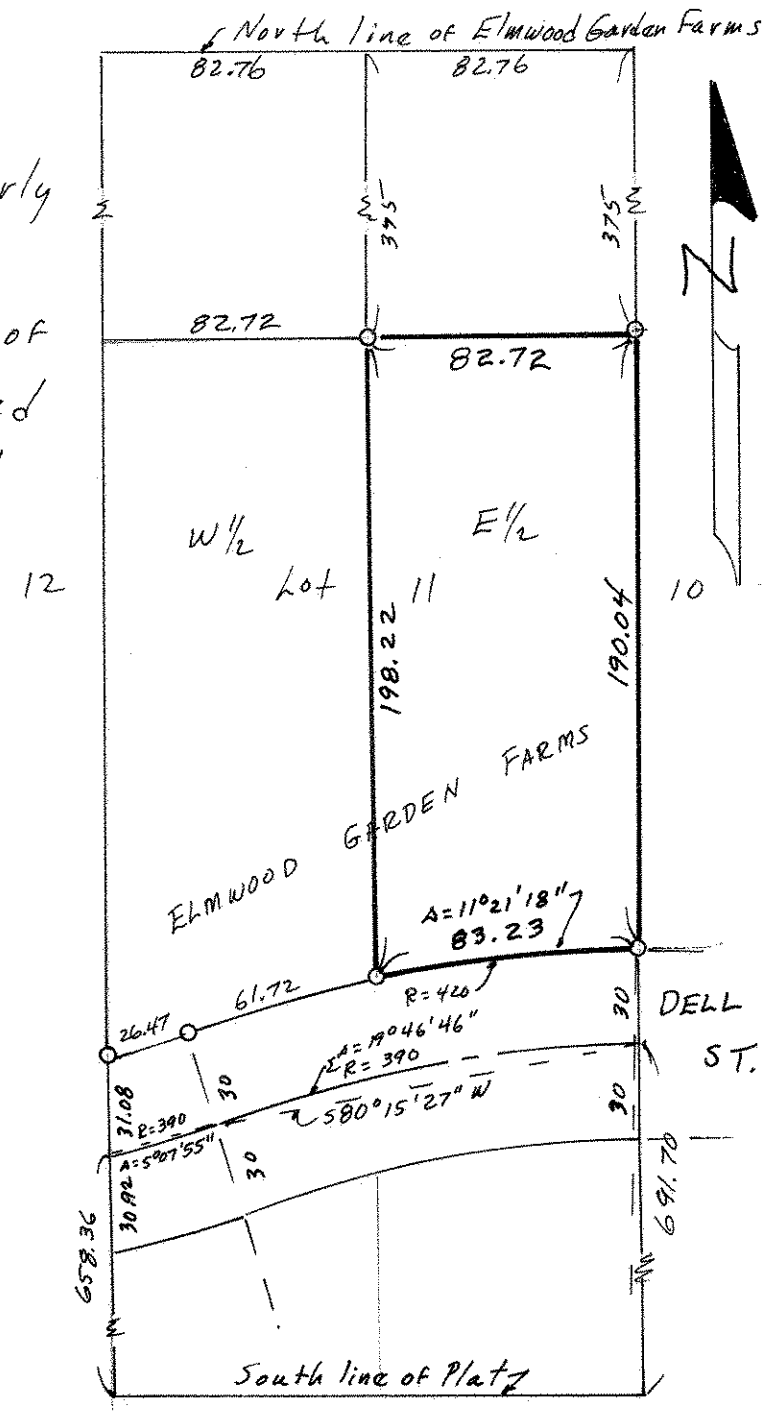

o Denotes Iron Monument