Certificate of Survey

From the office of

GEORGE SCHMIDT & ASSOC. INC.

8082 No. Lexington Ave., Roseville, Minn. 55113

LAND SURVEYING

483-4408

I Hereby Certify that this plat shows a survey made by me of the property described on this plat and that the corners are correctly placed as shown

Job Number: 1483

Surveyed For

Date

Scale

By

REGISTERED LAND SURVEYOR

Description:

Lot 16, Block 1, Brunet Addition

Ramsey County, Minn.

○ Denotes Iron Pipe Monument Set
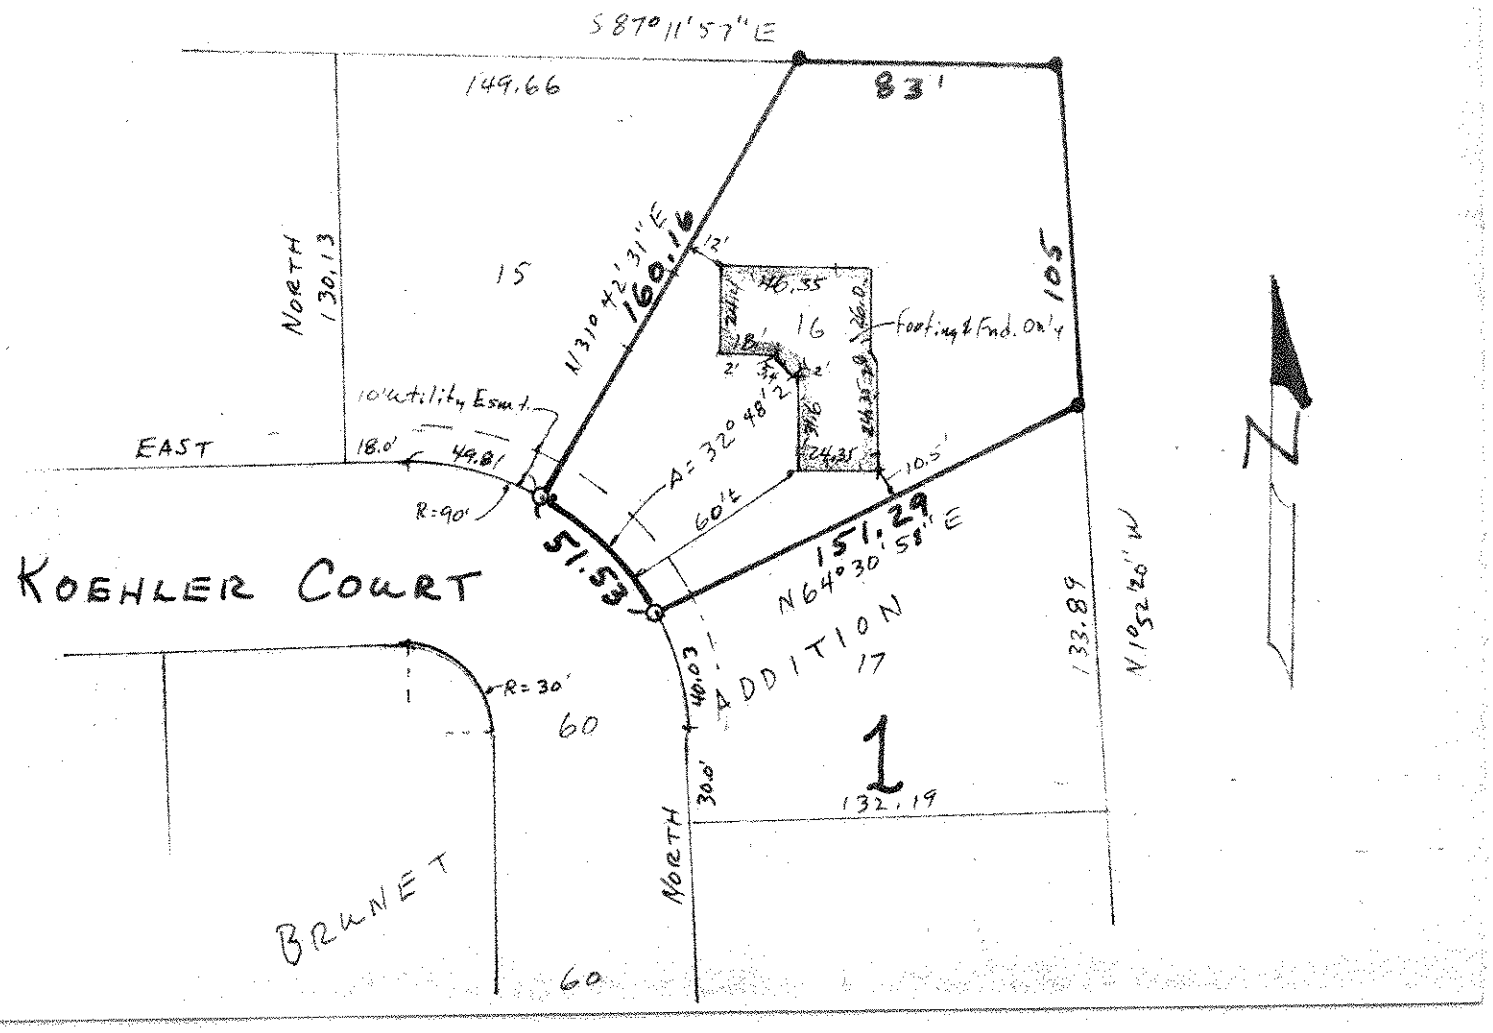
● Denotes Iron Found in place