SW 15 30 22

FROM THE OFFICE OF

CHARLES O. GEORGI COMPANY

2215 West County Road B — Saint Paul, Minnesota 55113

REGISTERED CIVIL ENGINEER AND LAND SURVEYOR

Certificate of Survey

I Hereby Certify that this plat shows a survey made by me of the property described on this plat, and that the corners are correctly placed as shown, and that all locations have been correctly shown.

Surveyed For Richard H. Gillitzer

Date 3/30/66

Scale 1" = 50'

By Charles O. Georgi
REGISTERED LAND SURVEYOR

Description: (present owner Lot 1A)
Lot 1A, Block 1, Brennan Addition except that part lying SWly of the below described line,
Also, all that part of Lot 2A, Block 1, Brennan Addition lying NEly of the below described line

Description (present owner Lot 2A)
Lot 2A, Block 1, Brennan Addition except that part lying NEly of the below described line.
Also, all that part of Lot 1A, Block 1, Brennan Addition lying SWly of the below described line.
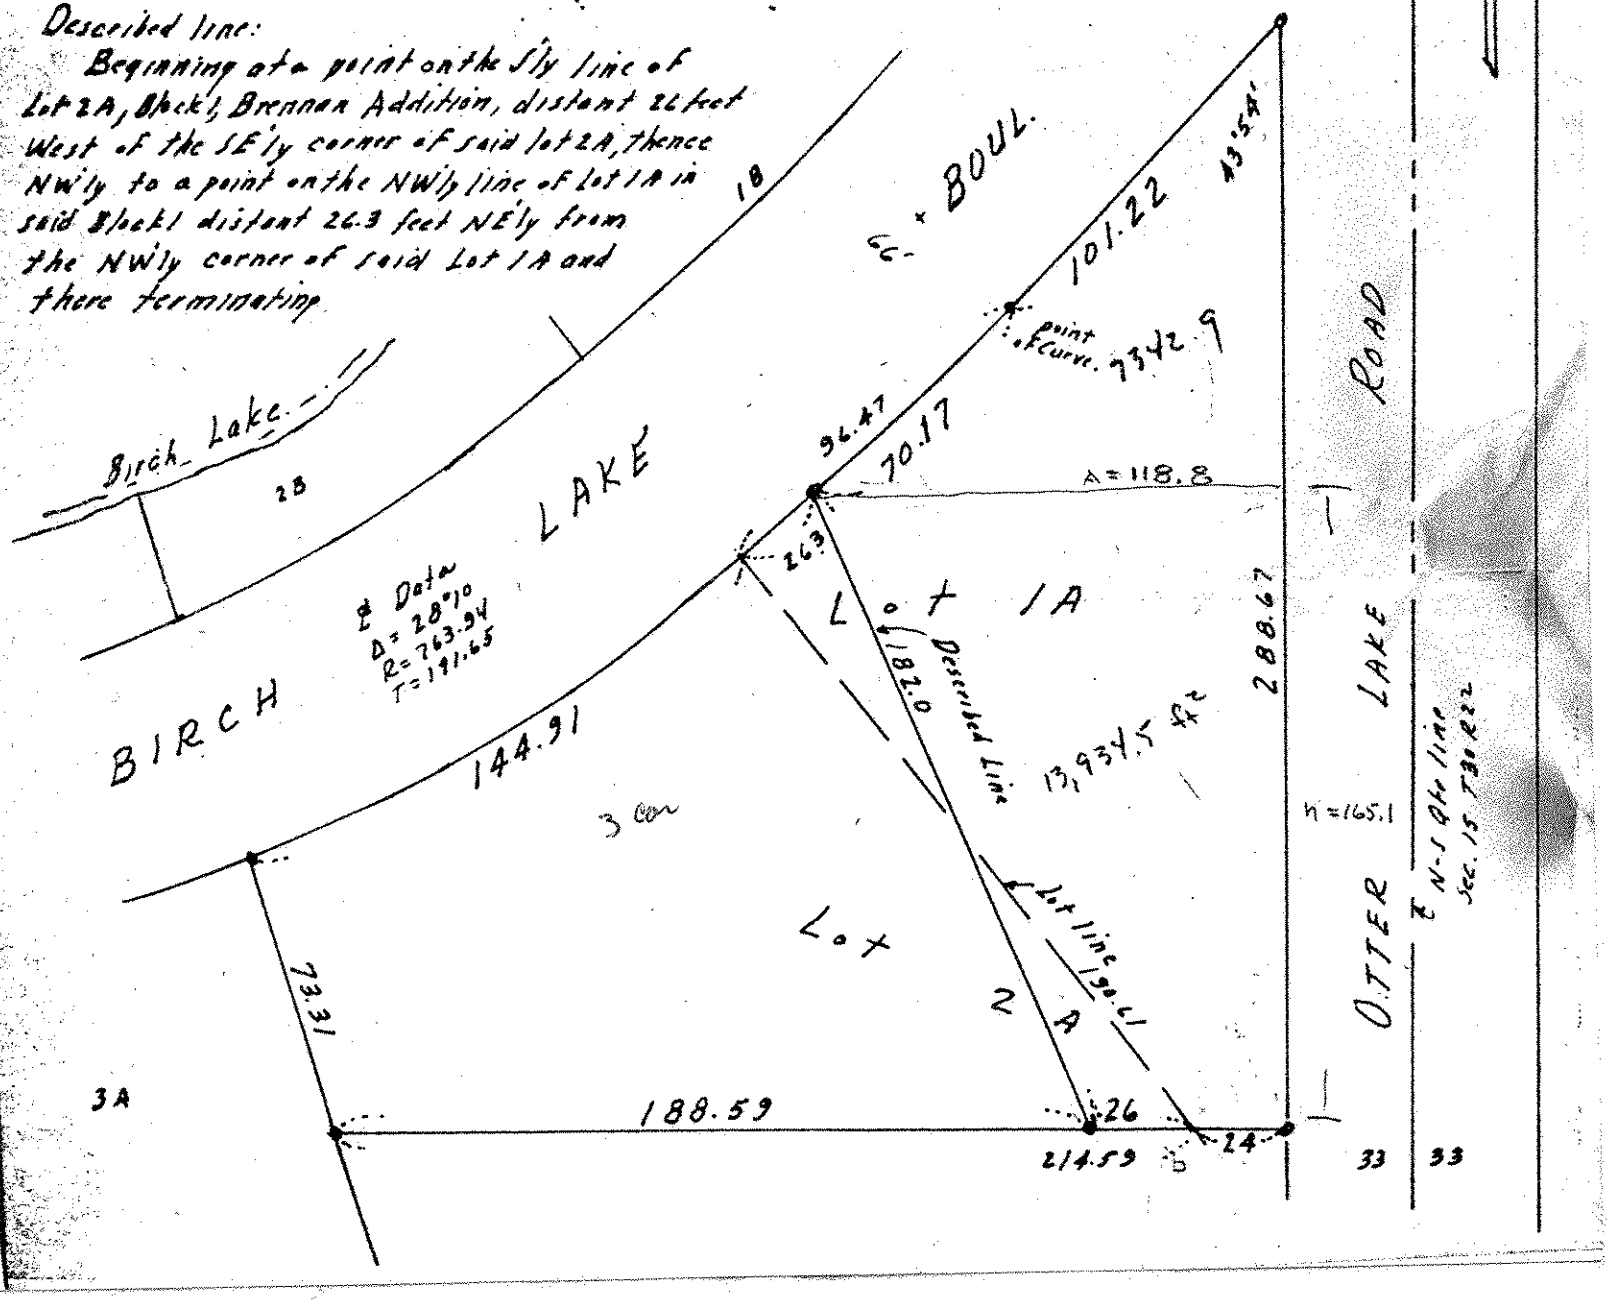
Described line:
Beginning at a point on the Sly line of Lot 2A, Block 1, Brennan Addition, distant 26 feet West of the SE'ly corner of said lot 2A, thence NW'ly to a point on the NW'ly line of Lot 1A in said Block 1 distant 26.3 feet NE'ly from the NW'ly corner of said Lot 1A and there terminating