PLAT OF SURVEY


OF PROPERTY OF Richard A. Kostuch.

DESCRIBED AS FOLLOWS Let 14. Brennan Addition, Ramsey County, Minn

Garner - Offer Lake Road & Highway #96. White Bear, Minn.

SCALE: 1 INCH 40 FEET

T. J. WELCH, REGISTERED SURVEYOR 738 SURREY AVENUE, ST. PAUL 6, MINN.

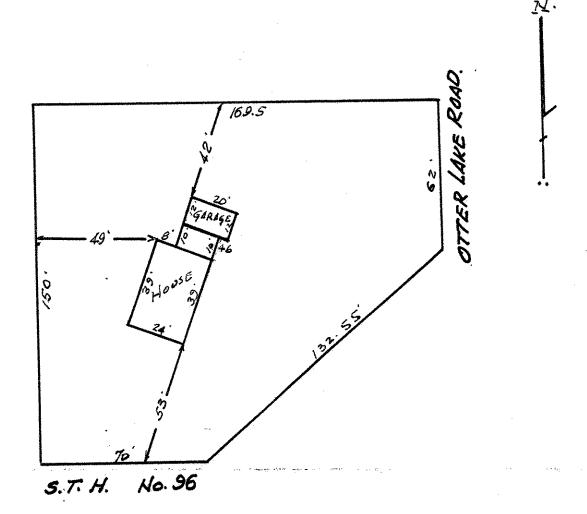

CERTIFICATE OF SURVEY

I hereby certify that on //- 2 z 19 54

I surveyed the property described above and that the above plat is a correct representation of said survey.

T.f.wefel.