


TELEPHONE TOWER 0640

# PLAT OF SURVEY

OF PROPERTY OF Richard A. Kostuch  
DESCRIBED AS FOLLOWS Lot 13 Block 1 Brennan Addition  
No 1517 State Trunk Highway No 96, Ramsey County, Minn.

SCALE: 1 INCH = 30 FEET

T. J. WELCH, REGISTERED SURVEYOR  
738 SURREY AVENUE, ST. PAUL 6, MINN.

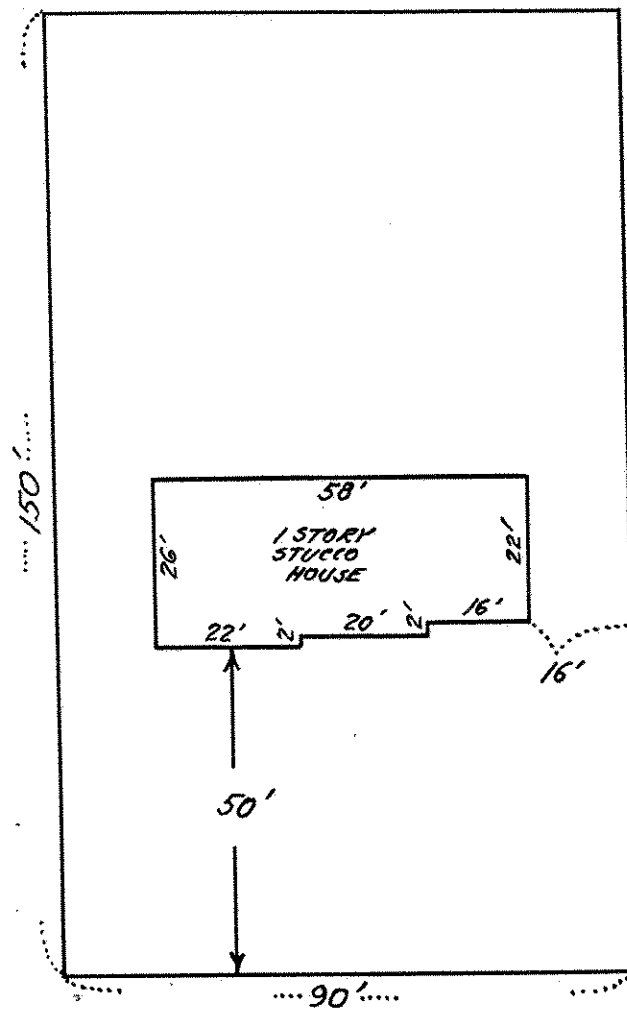

## CERTIFICATE OF SURVEY

I hereby certify that on 10-20 1956

I surveyed the property described above and that the above plat is a correct representation of said survey.

J. J. Welch