


11-20-14
LOTS 15, 16, 17, 18, 19, 20, 21.
BLOCK 10.

TOWN OF
BALD EAGLE.

JOHN B. IRVINE, SURVEYOR.
ST. PAUL, MINN.
SEPT 17-1910
SCALE 40 ft. per inch.

Handwritten flourish

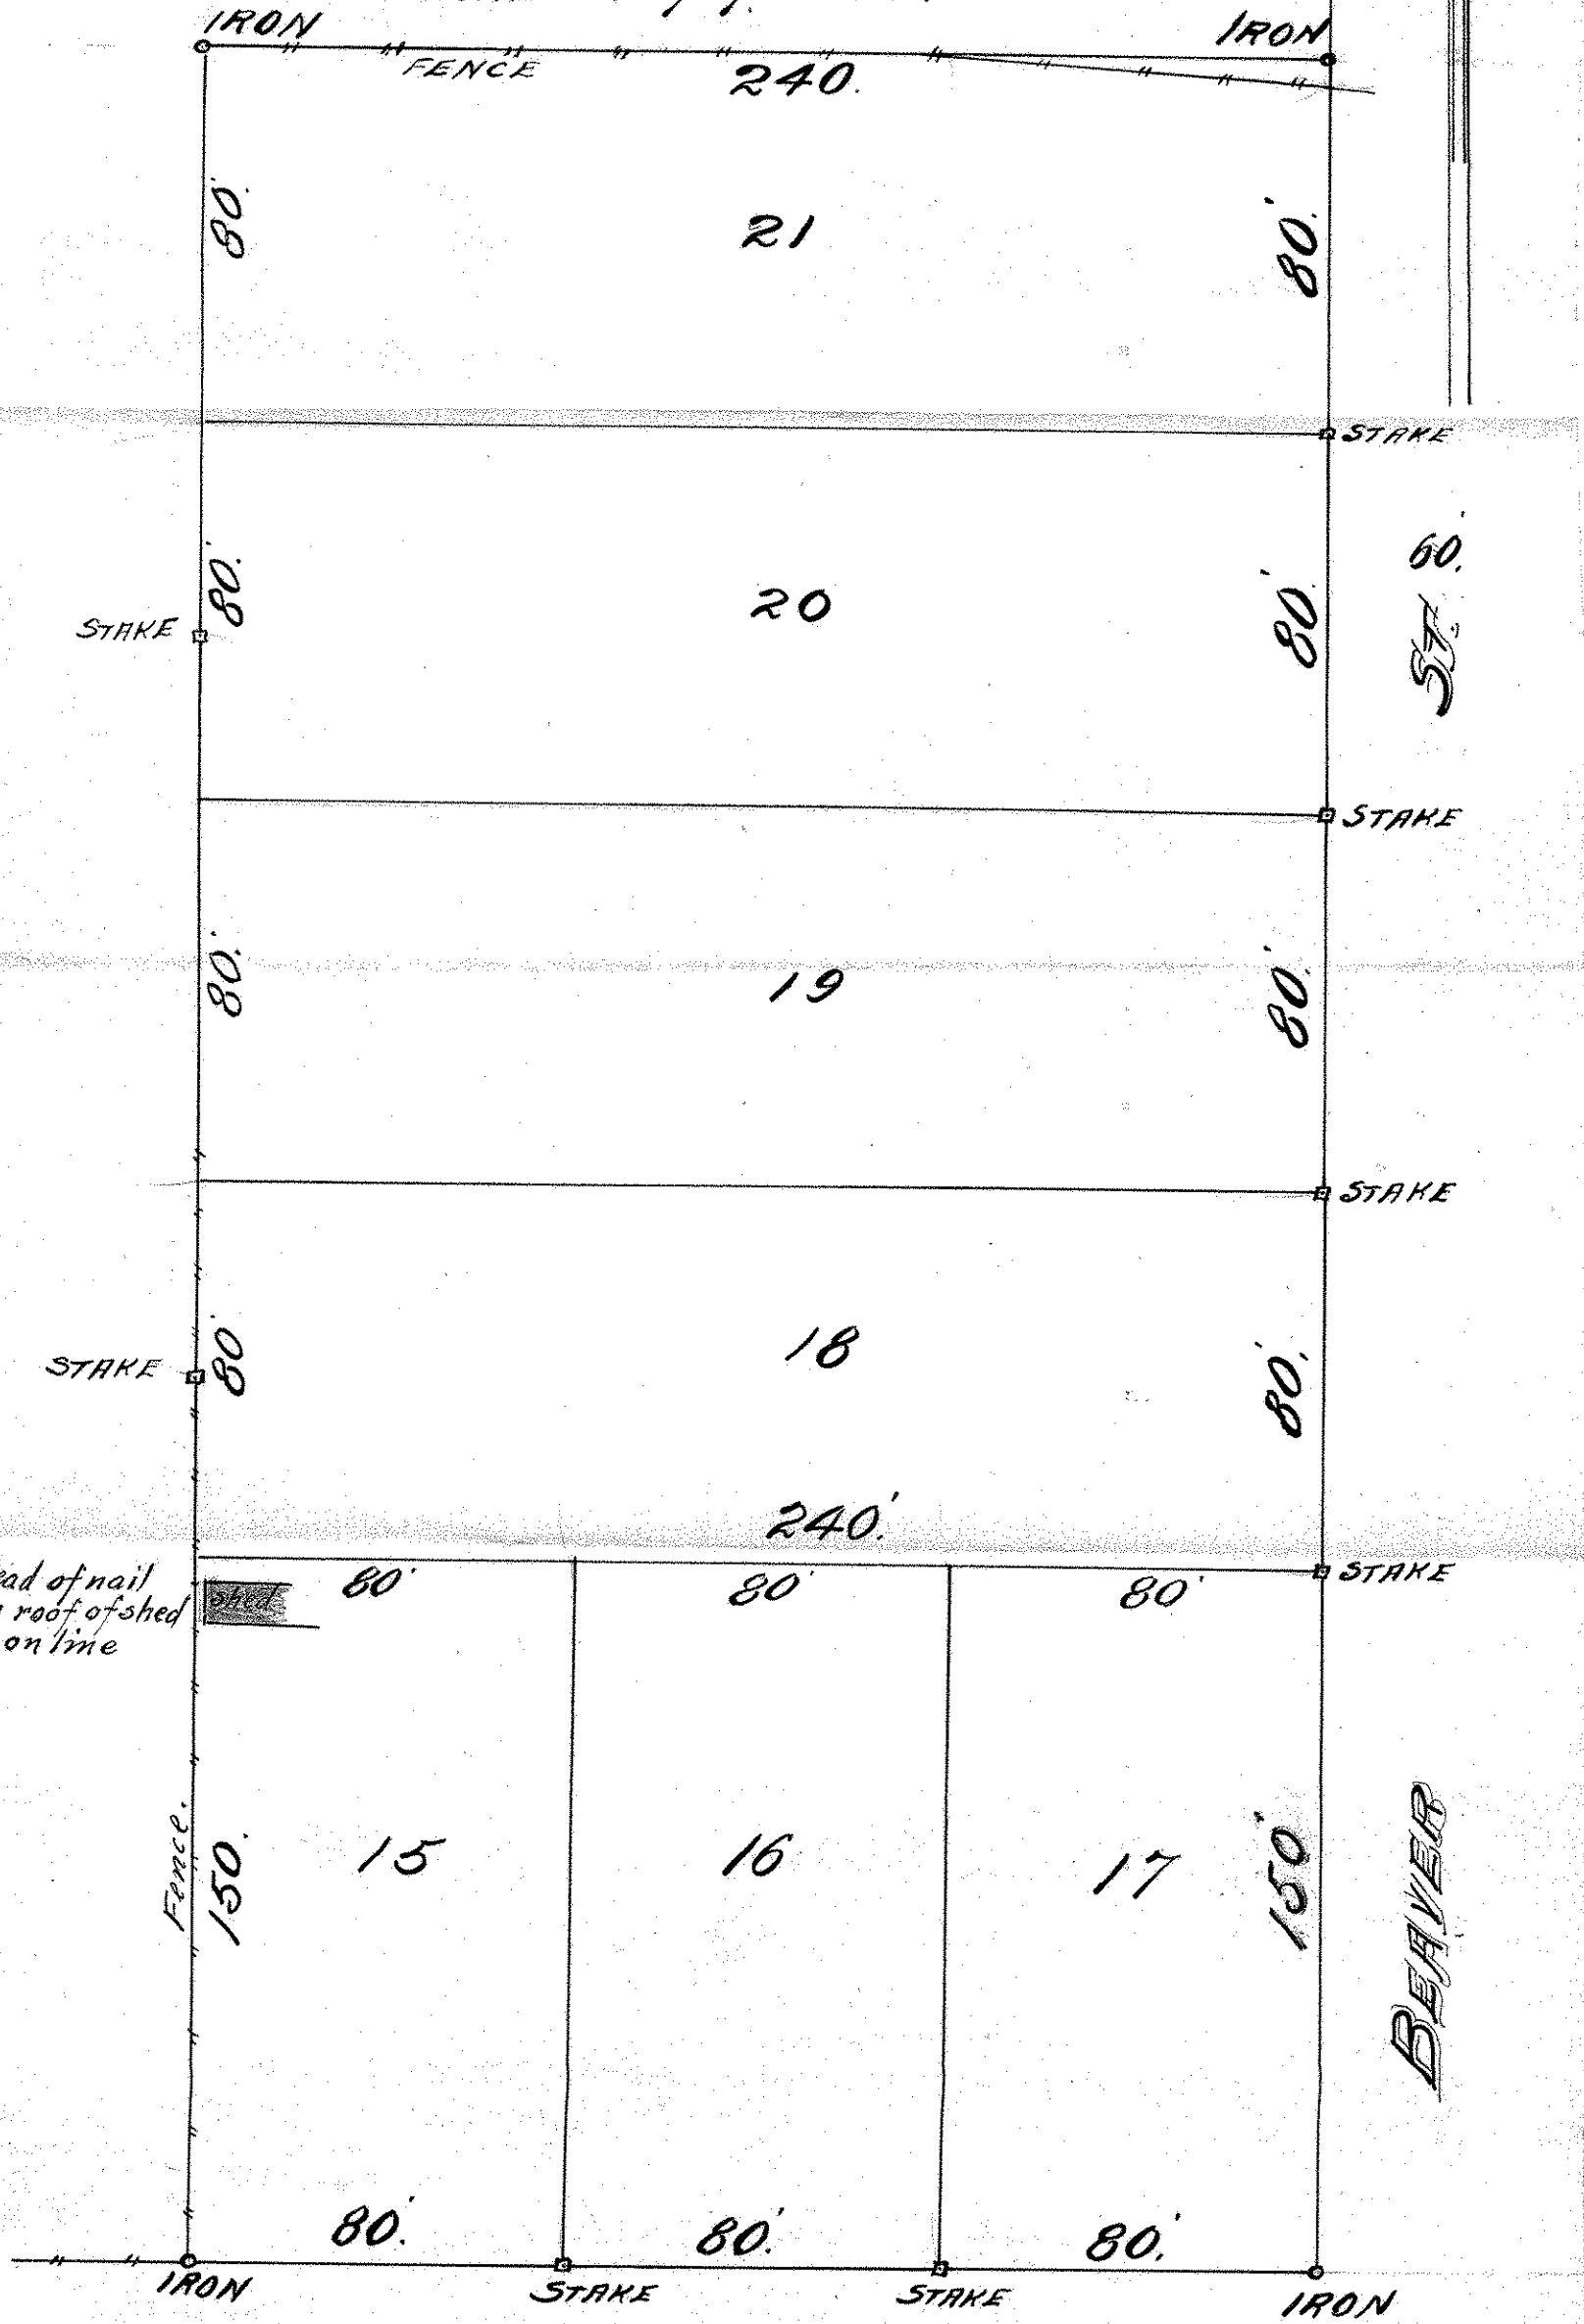

STILLWATER ST. 60