11-30-22

BLK. 15.

EXCEPT LOT 5.

TOWN OF BALD EAGLE.
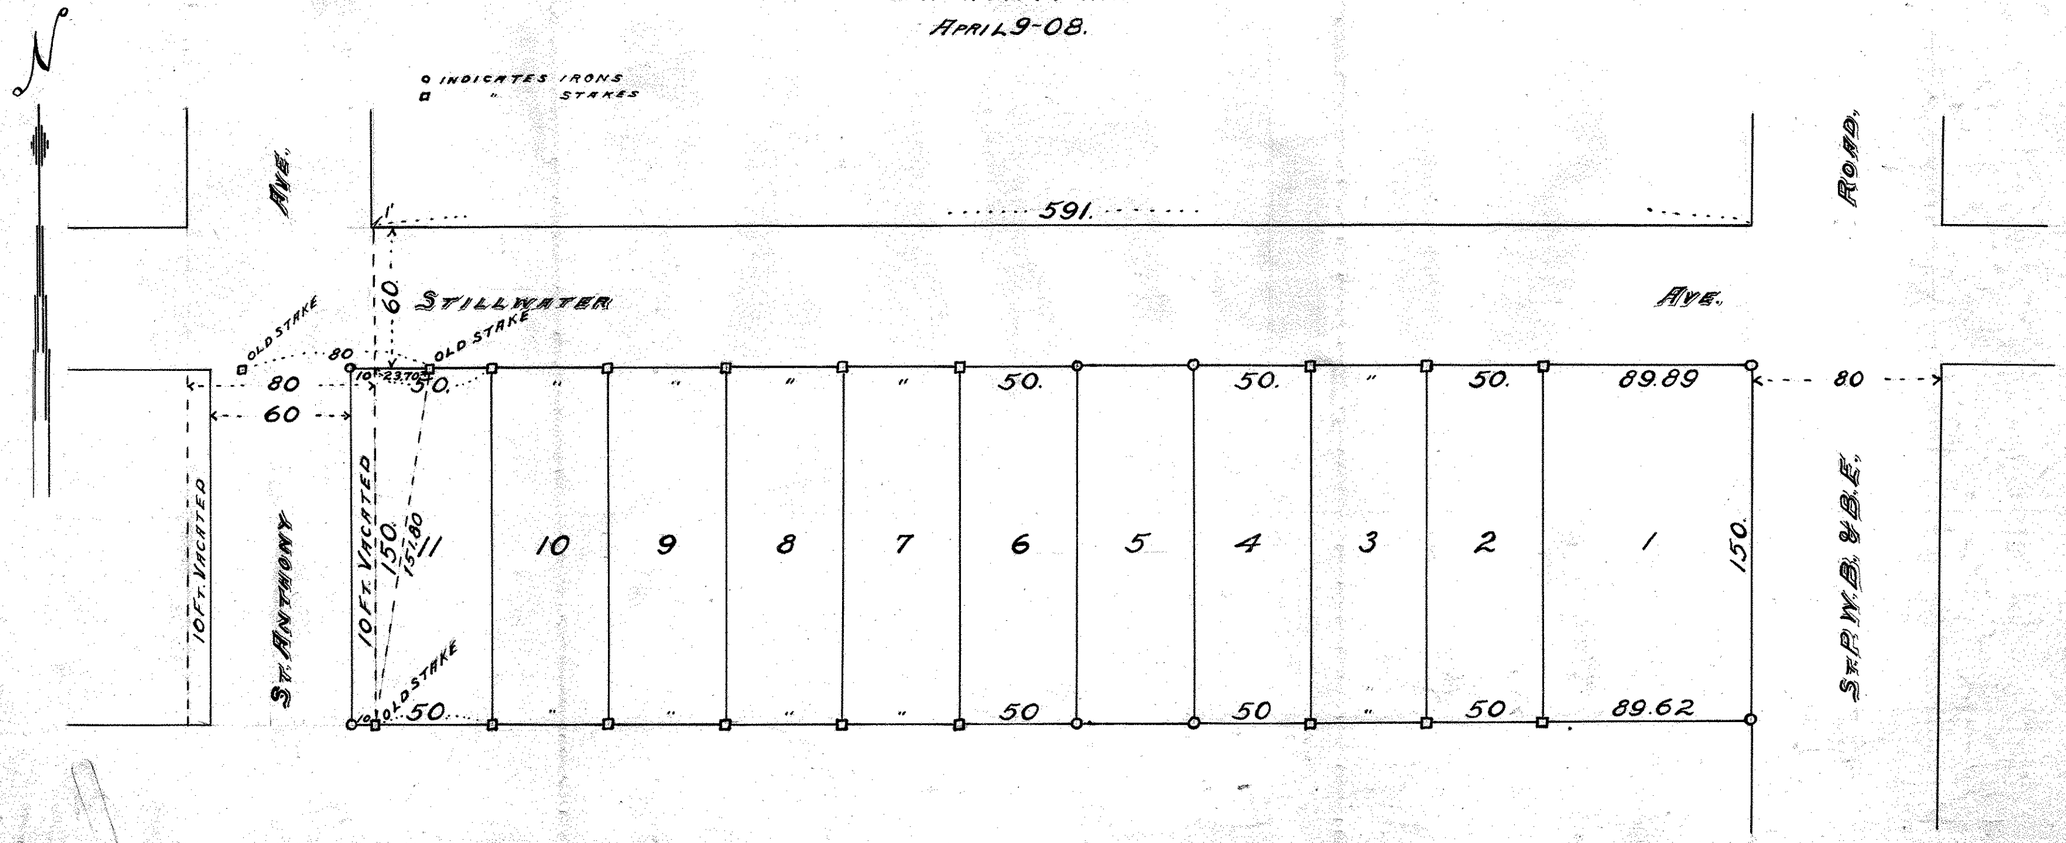
JOHN B. IRVINE, SURVEYOR.
ST. PAUL MINN.
APRIL 9-08.