


④ 11-30-22

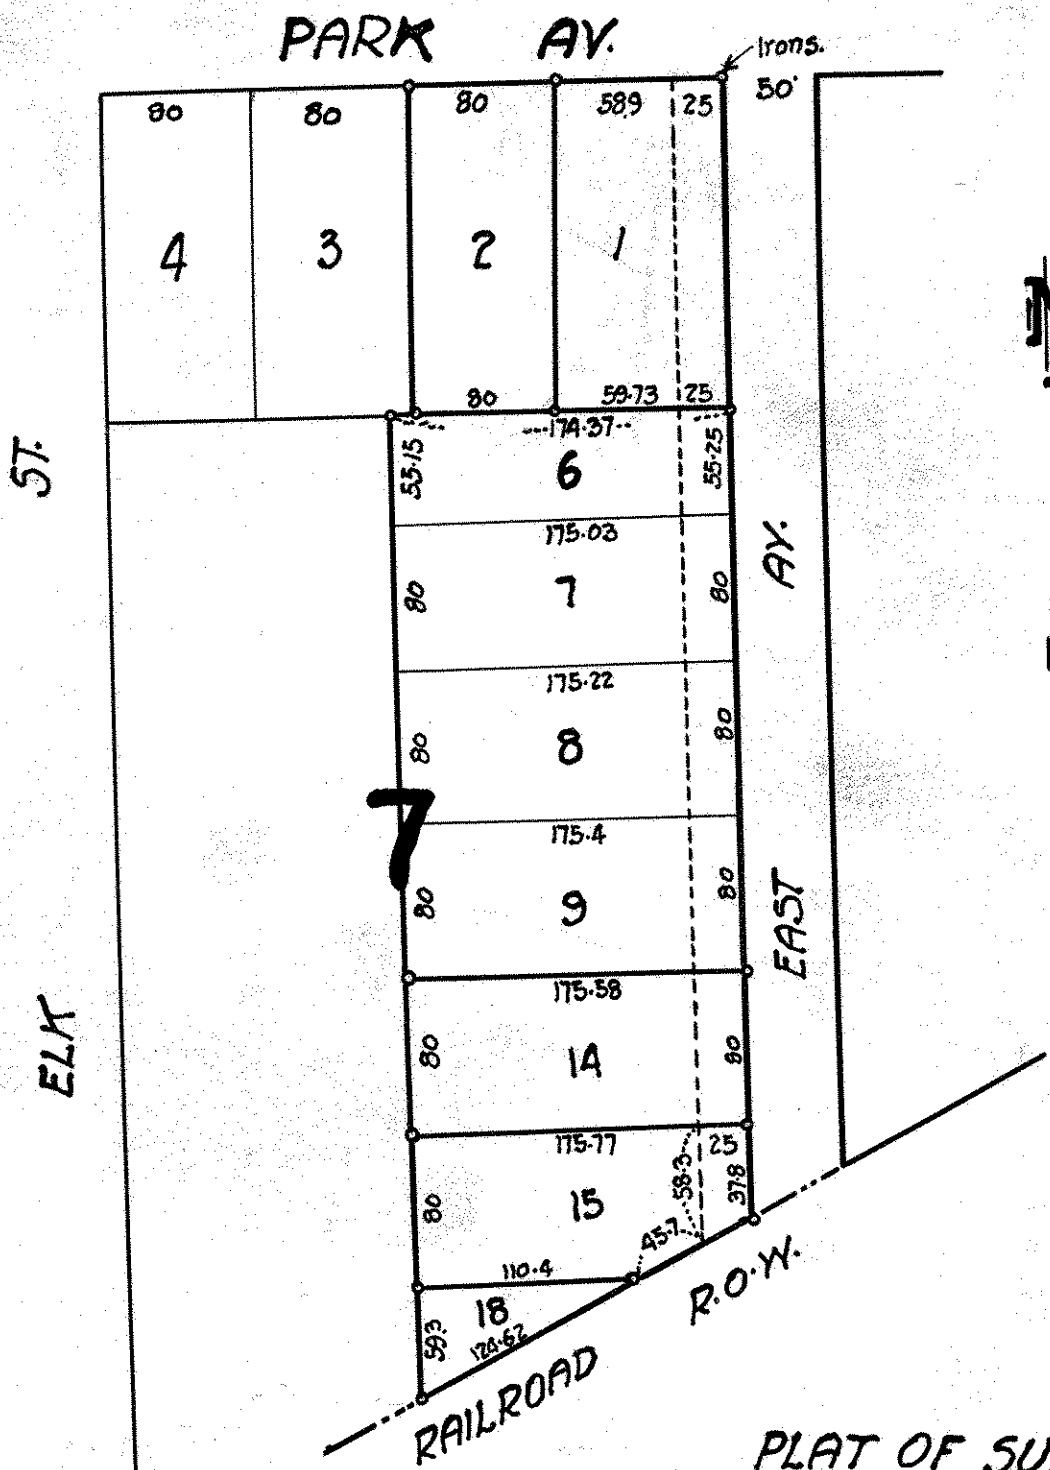

Scale - 1" = 100'  
Aug. 1, 1929

PLAT OF SURVEY  
OF  
LOTS-1, 2, 6, 7, 10, 11, 14, 15 and 18  
BLOCK-7- BALD EAGLE.  
P.R. Banister, Consulting Engineer  
North St. Paul, Minn.