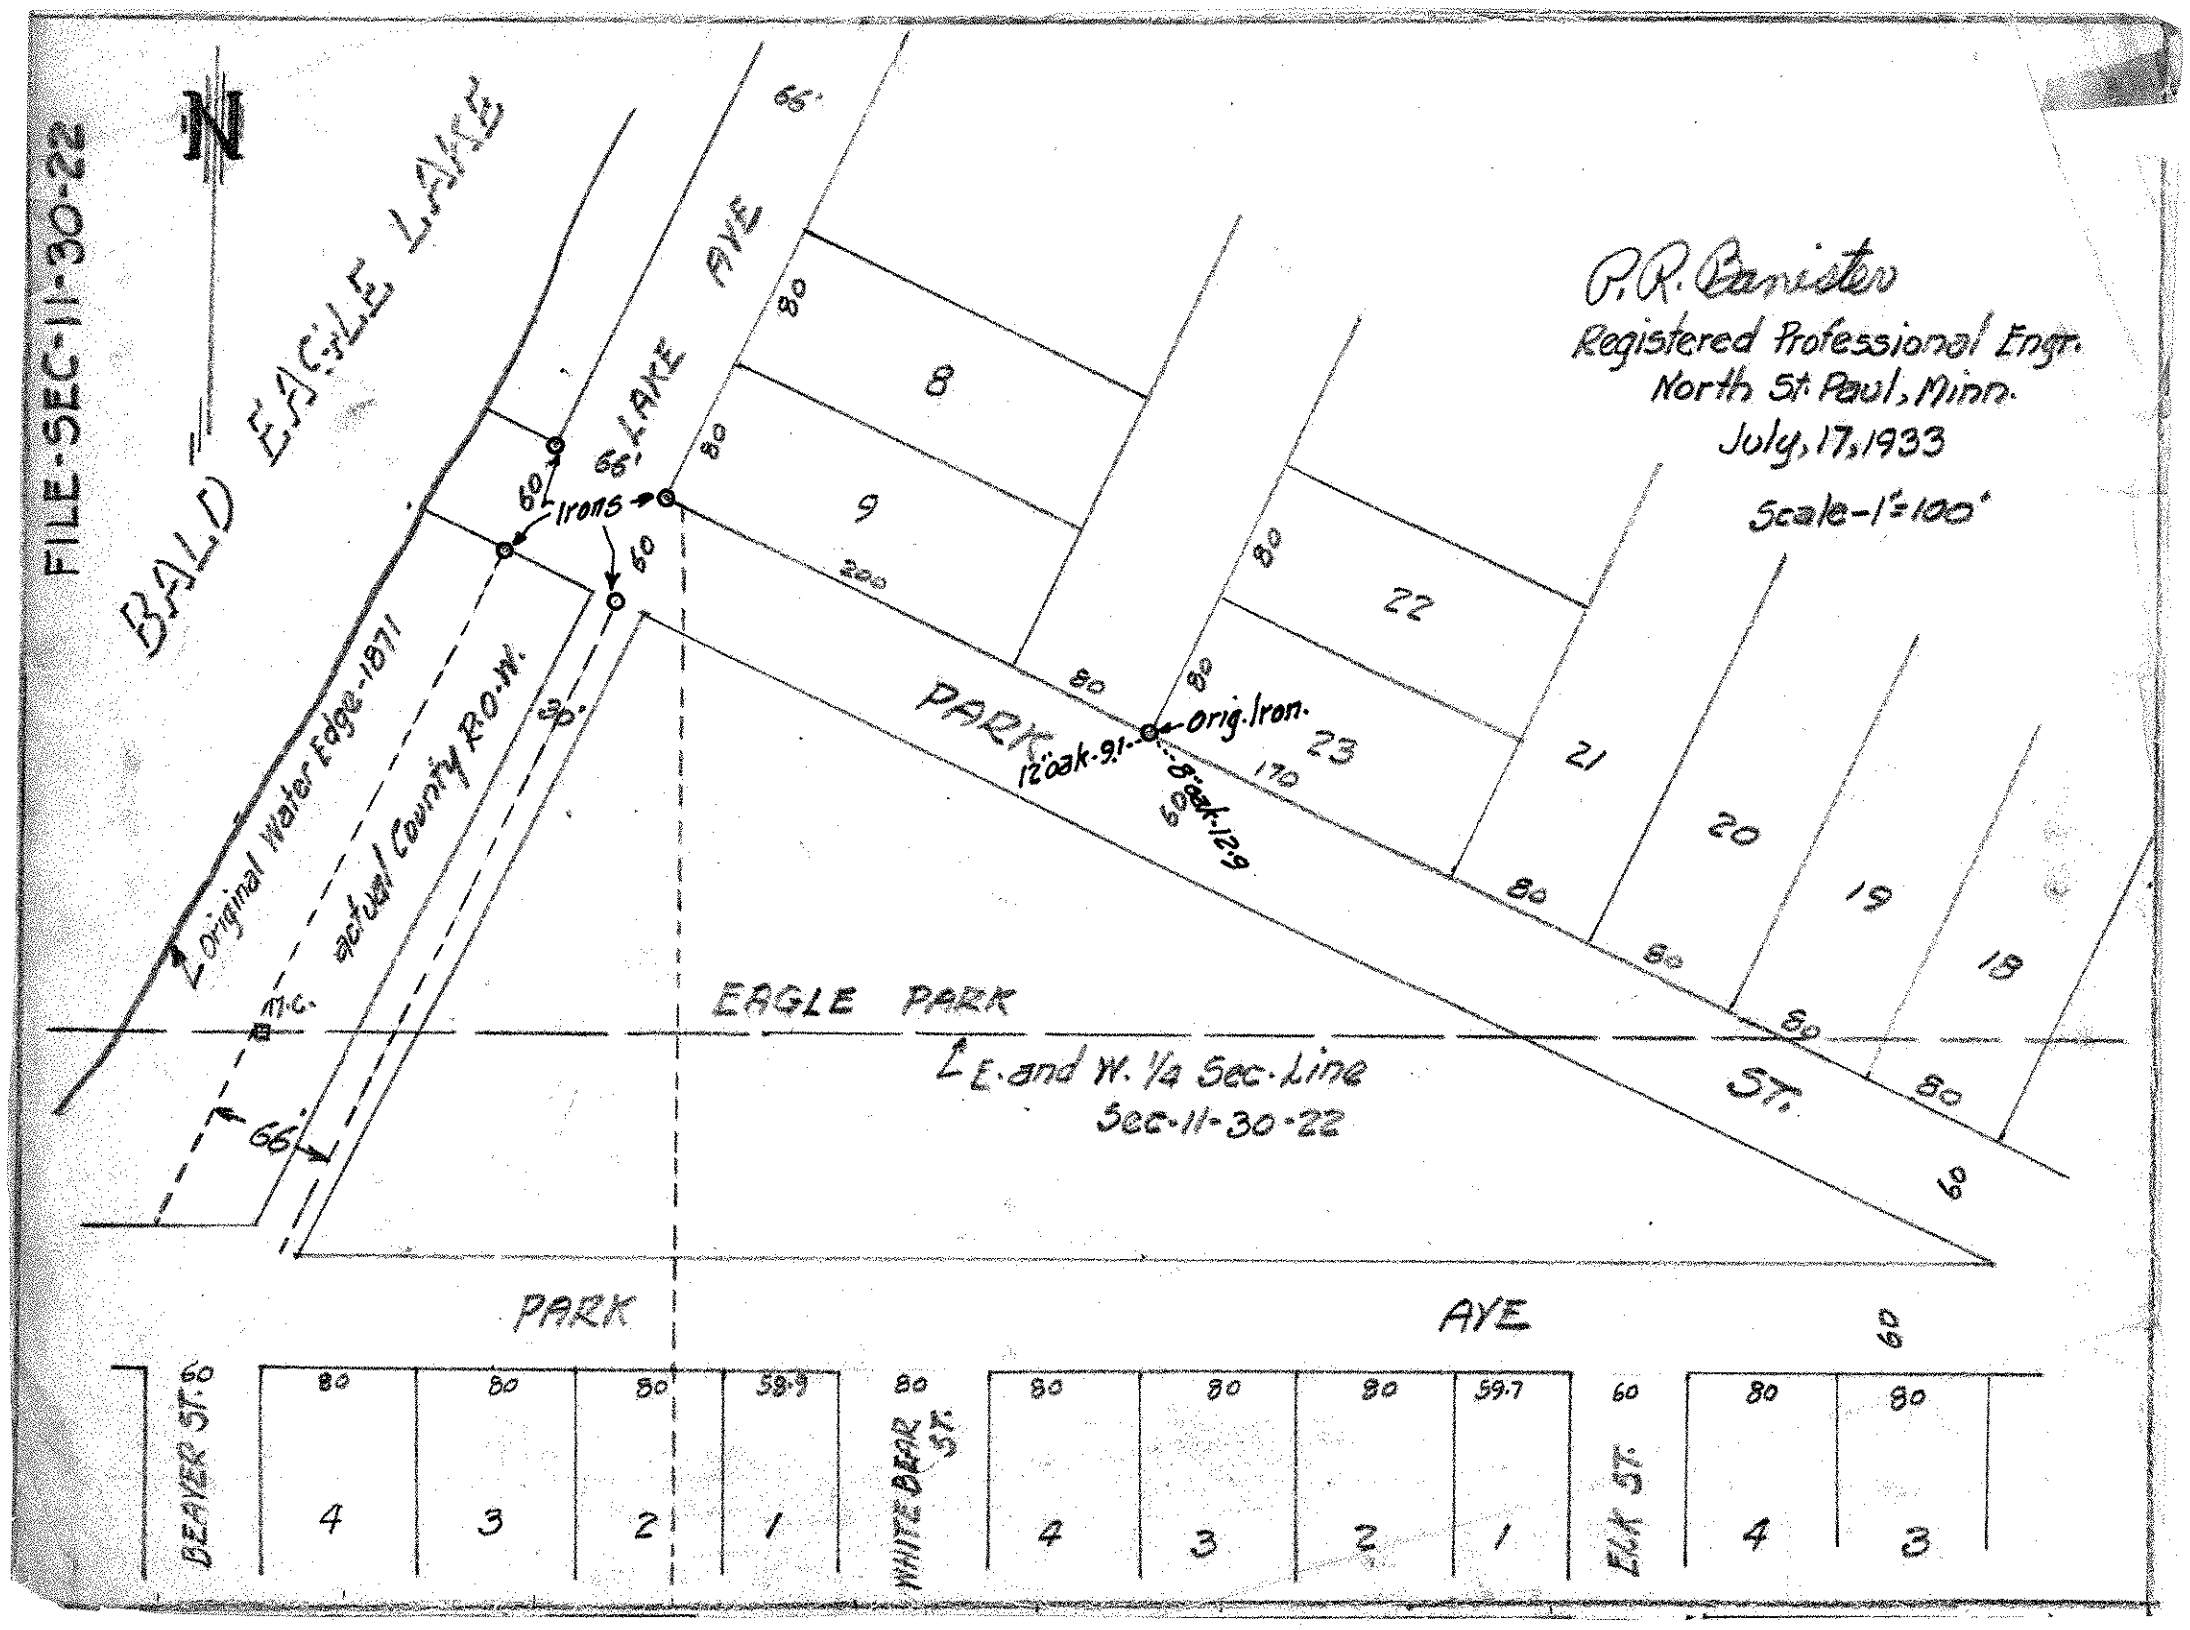
FILE-SEC-11-30-22
N
BALD EAGLE LAKE
LAKE AVE
66'
Original Water Edge-1871
actual County R.O.W.
M.C.
66'
60
Irons
60
30'
8
9
200
80
80
80
80
22
23
21
20
19
18
170
80
80
80
80
60
PARK
12" oak-9.1
Orig. Iron.
8" oak-12.9
60
EAGLE PARK
E. and W. 1/4 Sec. Line
Sec-11-30-22
ST.
PARK
AVE
60
BEAVER ST.
60
80
80
80
58.9
4
3
2
1
WHITE BEAR ST.
80
80
80
80
59.7
4
3
2
1
ELK ST.
60
80
80
4
3
P. R. Banister
Registered Professional Engr.
North St. Paul, Minn.
July, 17, 1933
Scale-1"=100'