SW 25 30 22

Certificate of Survey

FROM THE OFFICE OF

CHARLES O. GEORGI COMPANY

2215 West County Road B Saint Paul, Minnesota 55113

REGISTERED CIVIL ENGINEER AND LAND SURVEYOR

I Hereby Certify that this plat shows a survey made by me of the property described on this plat, and that the corners are correctly placed as shown, and that all locations have been correctly shown.

Surveyed For Charles Hamilton

Date July 1974

Scale 1" = 40'

By Donald P. Winchell

REGISTERED LAND SURVEYOR

Description:
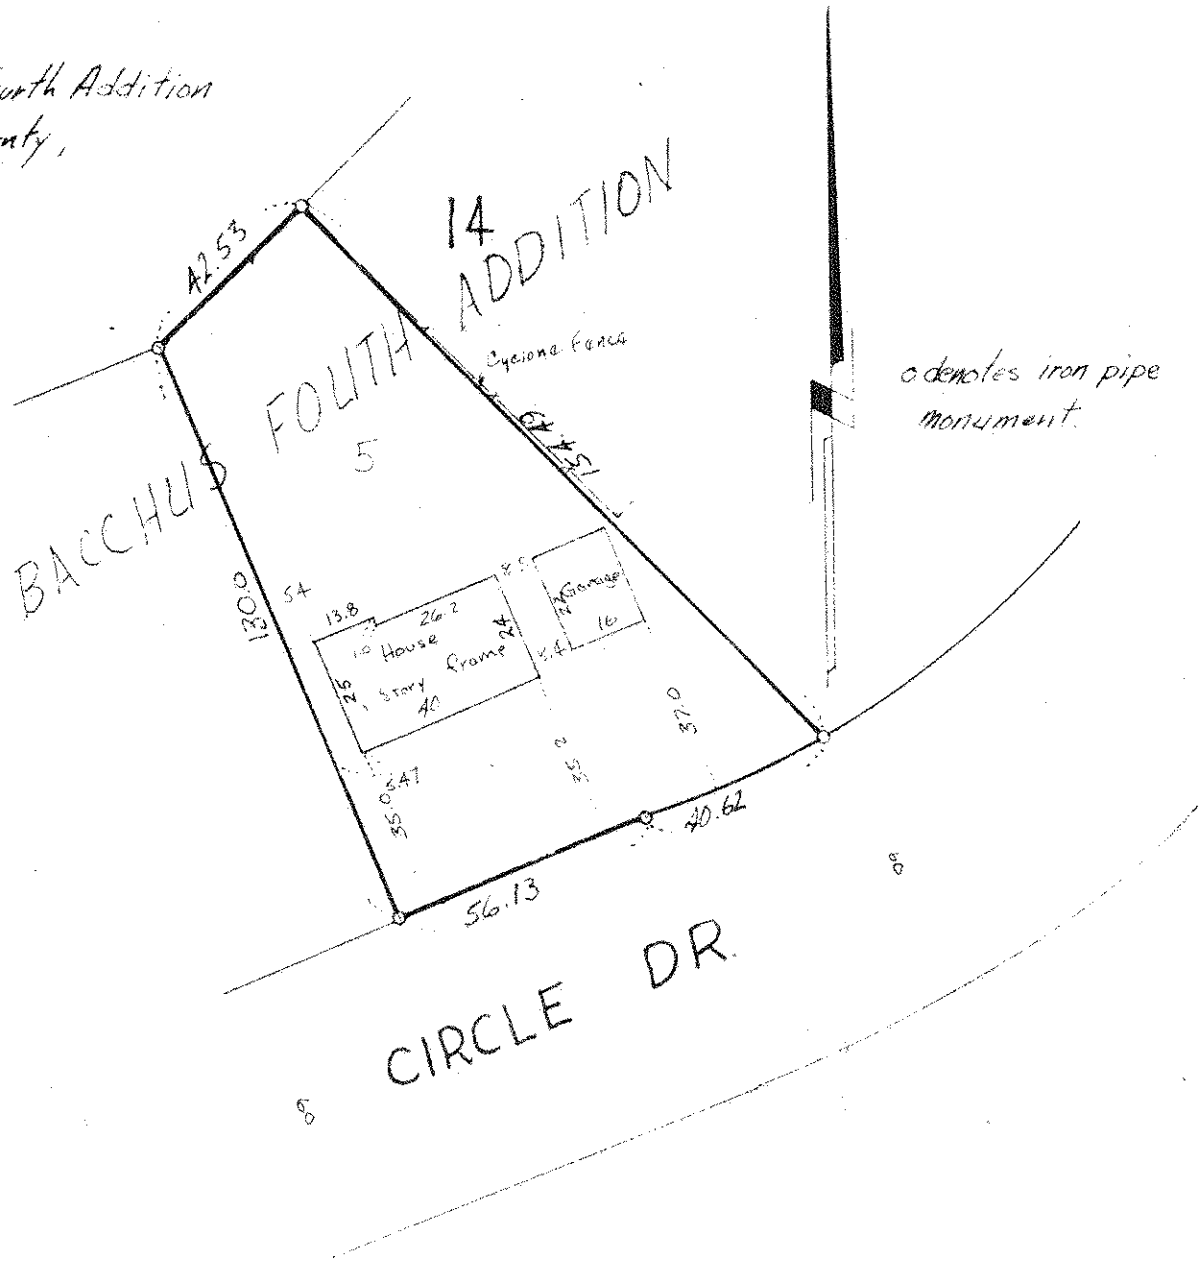
Lot 5,
Block 14,
Bacchus Fourth Addition
Ramsey County,
Minnesota.