SW 25 30 22

Certificate of Survey

From the office of

GEORGI- SCHMIDT & ASSOC. INC.

3092 No. Lexington Ave., Roseville, Mn. 55113

LAND SURVEYING

483-4408

I Hereby Certify that this plat shows a survey made by me of the property described on this plat, and that the corners are correctly placed as shown.

Job Number: 1450

Surveyed For Kenneth Vogas

Date 8/29/83

Scale 1" = 40'

By Donald W. Schmidt

REGISTERED LAND SURVEYOR

#10459

Description:

Lot 2, Block 19, Bacchus Fourth Add.
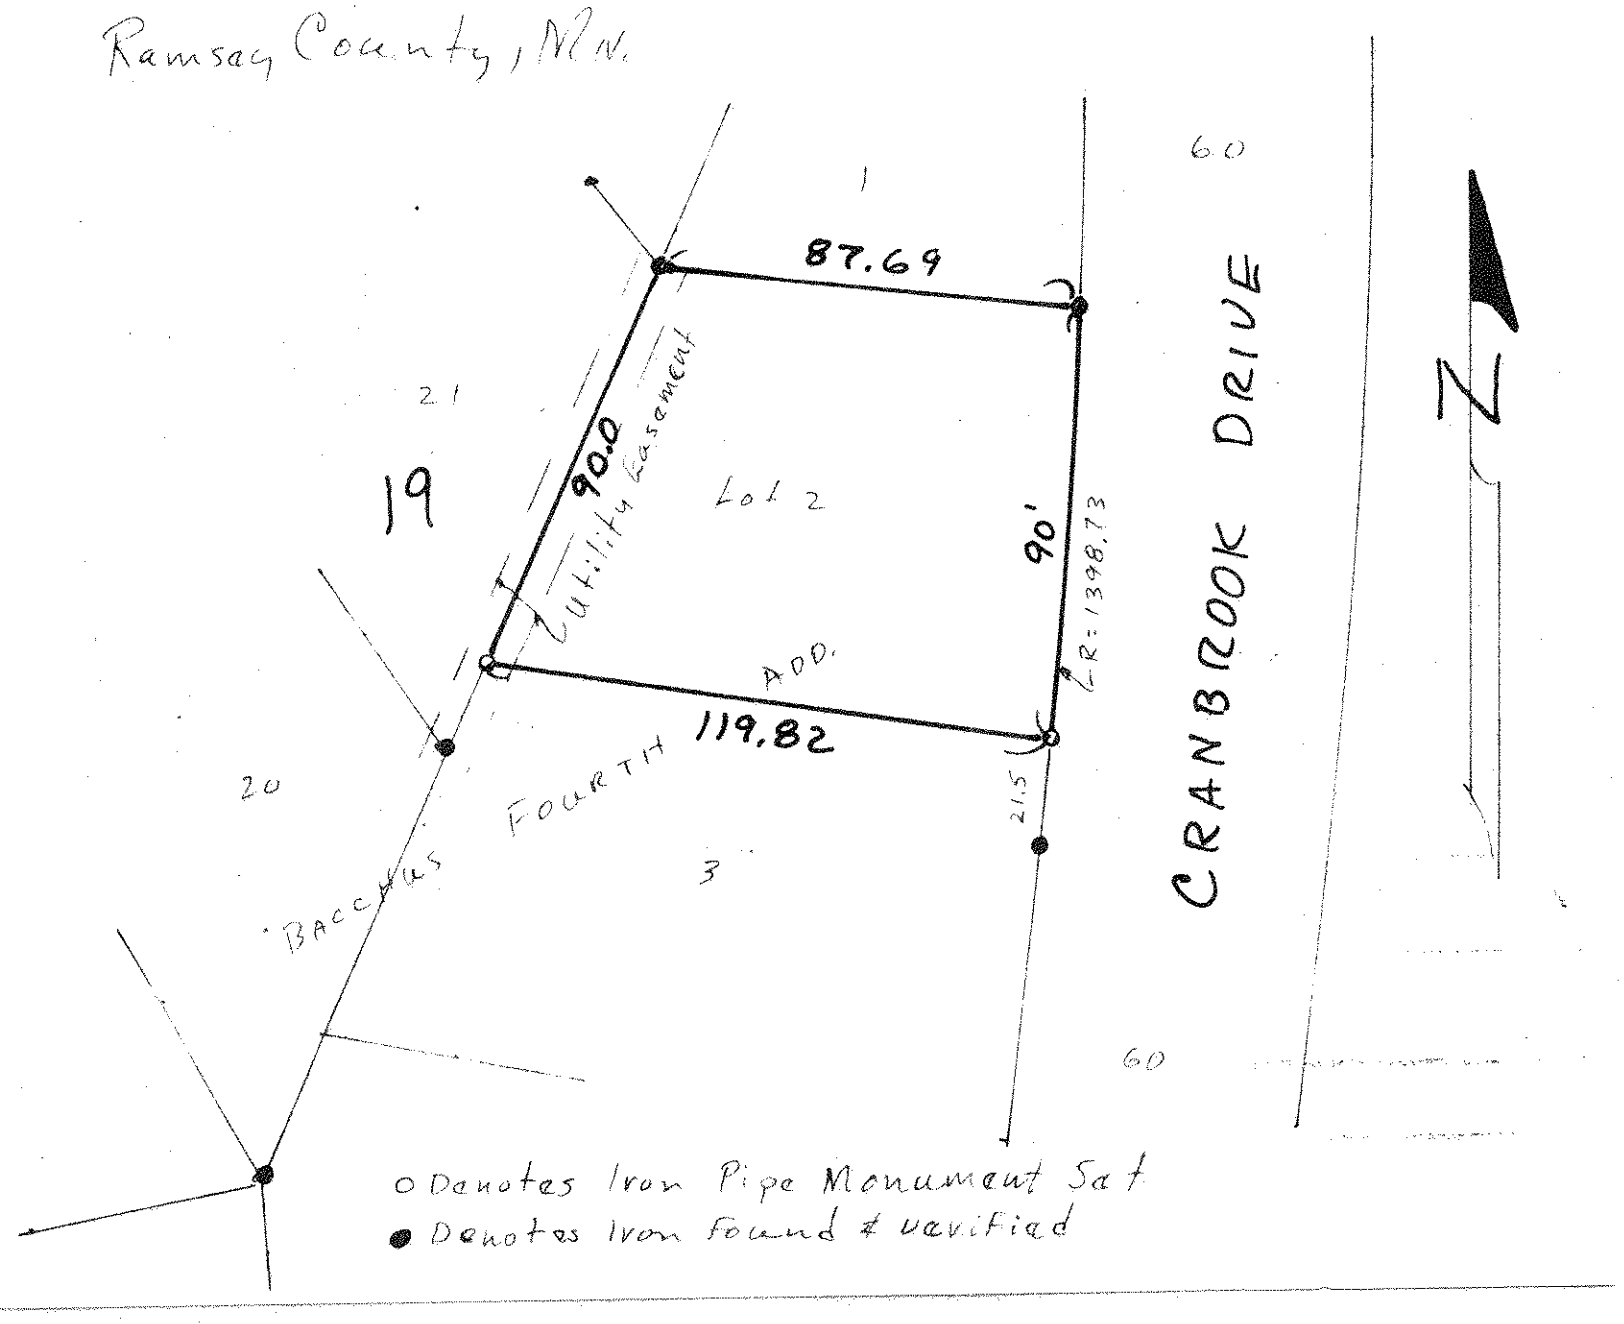
Ramsey County, Mn.