FROM THE OFFICE OF

Certificate structure stru

CHARLES O. GEORGI COMPANY

2215 West County Road B

Saint Paul, Minnesota 55113

REGISTERED CIVIL ENGINEER AND LAND SURVEYOR

I Hereby Certify that this plat shows a survey made by me of the property described on this plat, and that the corners are correctly placed as shown, and that all locations have been correctly shown.

Surveyed For Frank A. Arth


Date June 1967

Scale /"= 40'

y Charles O Leagi

Description:

Lot 19 Block 5 Eastwood Manor Ramsey County, Minn.

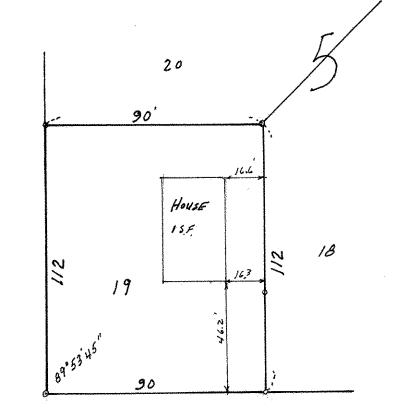

Denotes Iran pipe monument.

· ROTH

PLACE