NW 25 30 22

FROM THE OFFICE OF

CHARLES O. GEORGI COMPANY

2215 West County Road B Saint Paul, Minnesota 55113

REGISTERED CIVIL ENGINEER AND LAND SURVEYOR

Certificate of Survey

I Hereby Certify that **this plat shows a survey made by me of the property described on this plat, and that the corners are correctly placed as shown, and that all locations have been correctly shown.**

Surveyed For Frave Ranstrom

Date August 1974

Scale 1"=60'

By Charles O. Georgi

REGISTERED LAND SURVEYOR

Description:
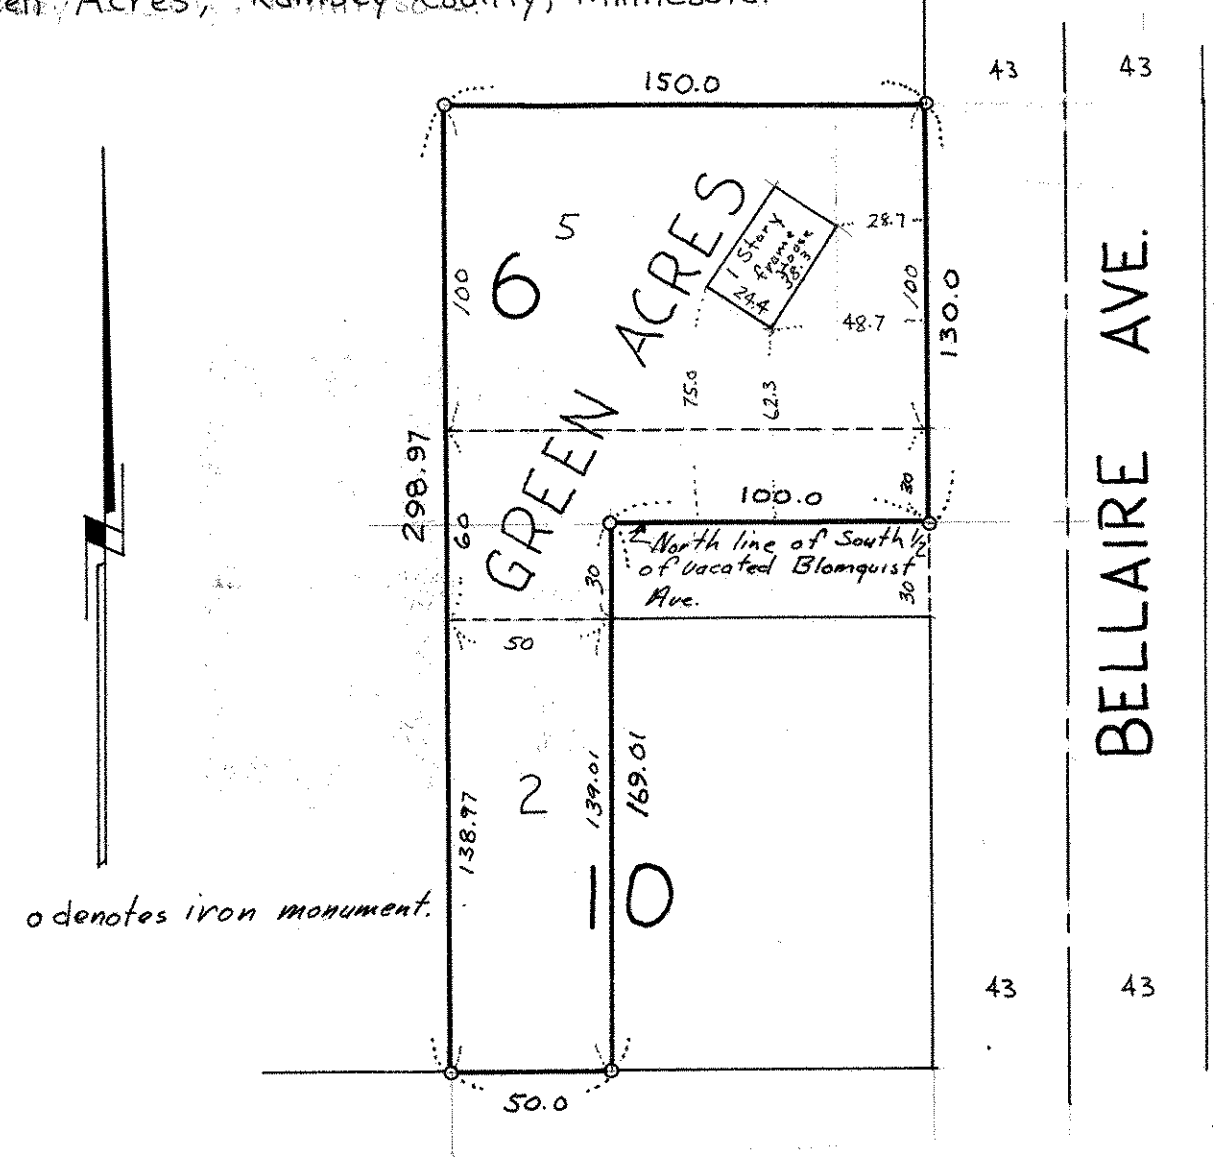
Lot 5, Block 6 and the adjoining North ½ of vacated Blomquist Ave., and also the East 50 feet of lot 2, Block 10, and the adjoining South ½ of vacated Blomquist Ave.; Green Acres, Ramsey County, Minnesota.