

FROM THE OFFICE OF

# CHARLES O. GEORGI COMPANY

2215 West County Road B

Saint Paul, Minnesota 55113

REGISTERED CIVIL ENGINEER AND LAND SURVEYOR

## Certificate of Survey

I Hereby Certify that this plat shows a survey made by me of the property described on this plat, and that the corners are correctly placed as shown, and that all locations have been correctly shown. and elevations have been correctly shown

Surveyed For *Steve Roberts*


Date *June 1975*

Scale *1"=30'*

By *Charles O. Georgi*  
REGISTERED LAND SURVEYOR

**Description:**

Lot 8,  
Block 1,  
Centre Acres,  
Ramsey County,  
Minnesota

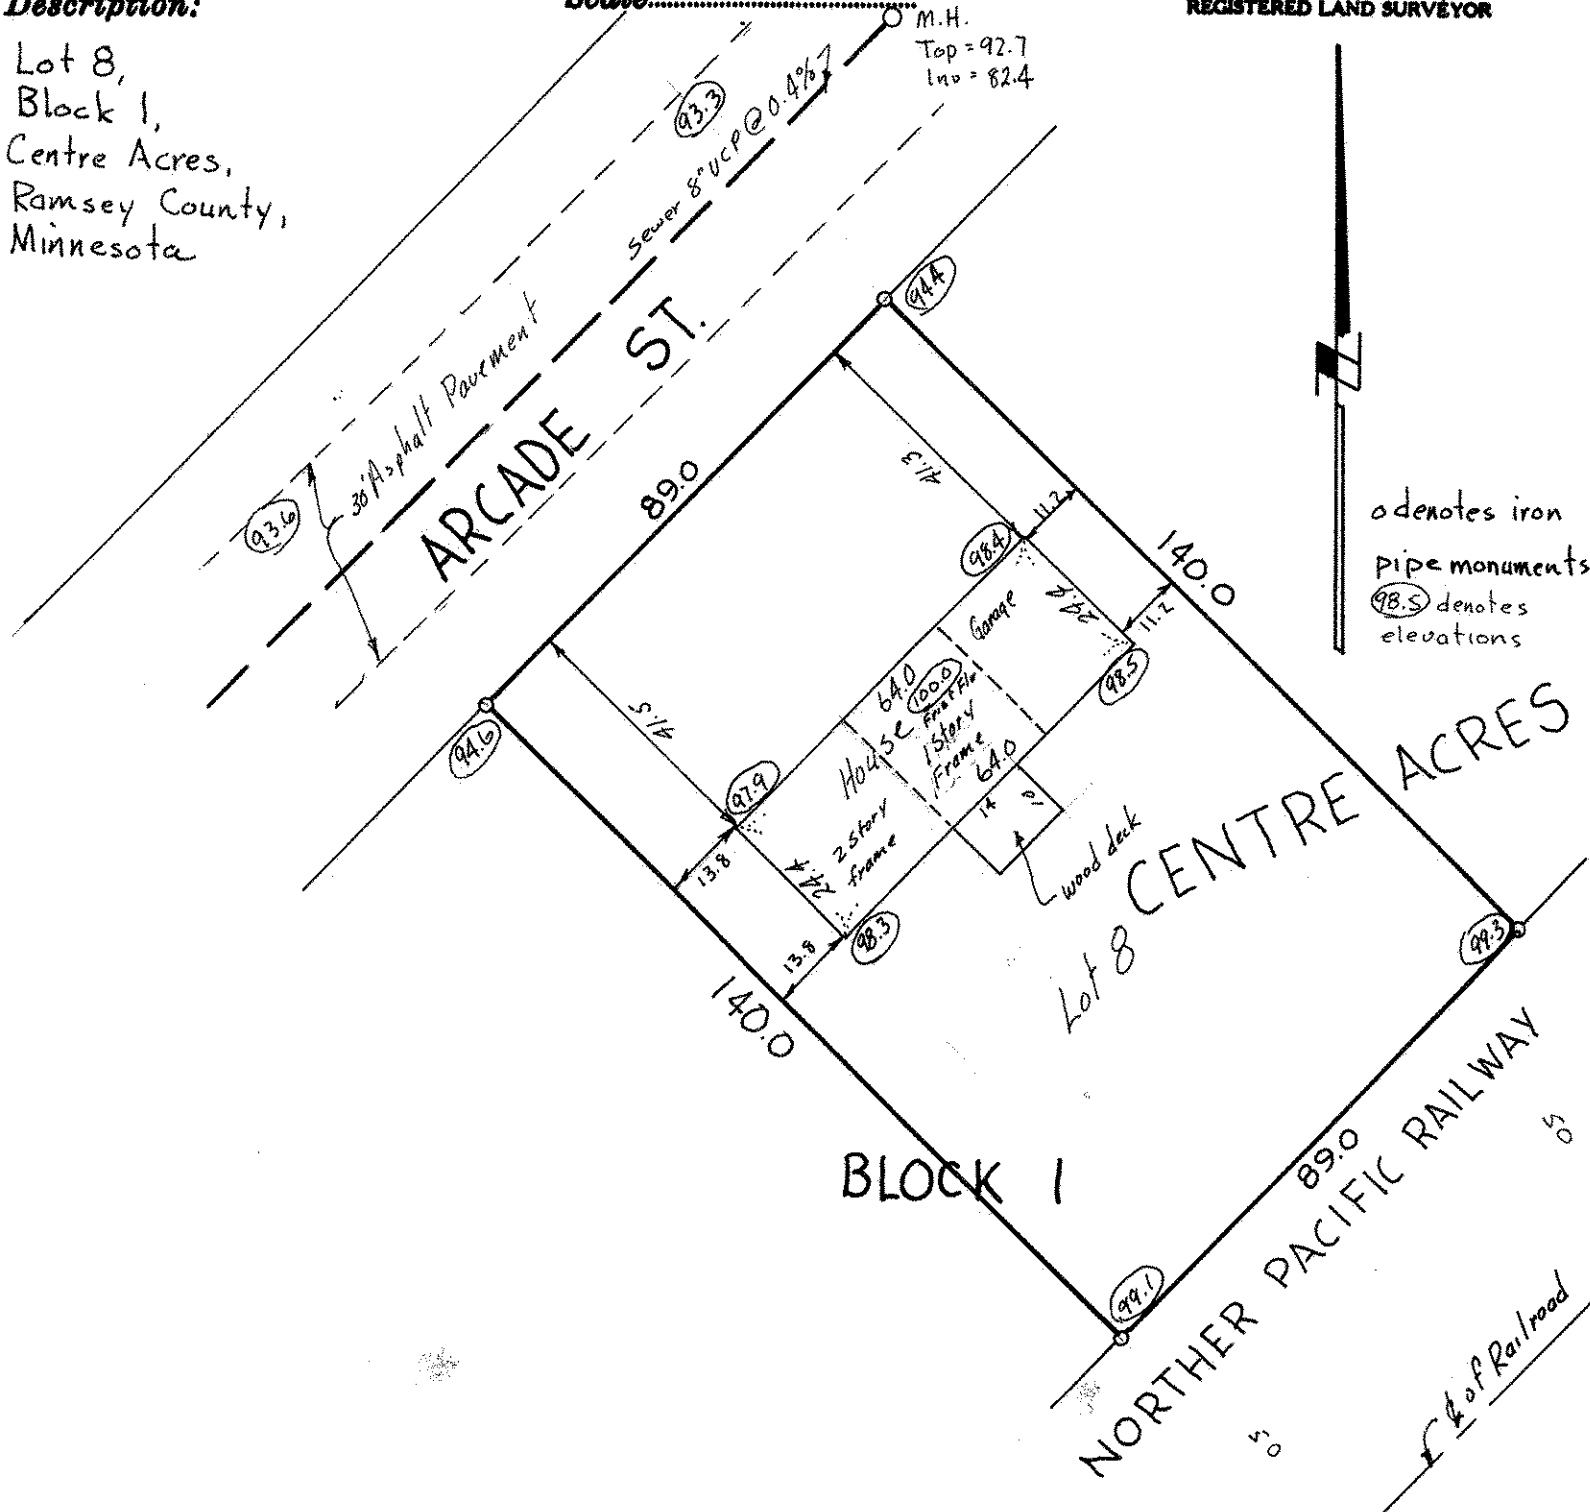

o denotes iron  
pipe monuments  
98.5 denotes  
elevations