

FROM THE OFFICE OF

CHARLES O. GEORGI COMPANY

2215 West County Road B

Saint Paul, Minnesota 55113

REGISTERED CIVIL ENGINEER AND LAND SURVEYOR

**Certificate
of Survey**

I Hereby Certify that this plat shows a survey made by me of the property described on this plat, and that the corners are correctly placed as shown, and that all locations have been correctly shown.

Surveyed For JACK ROBERTS


Date APRIL 1969

Scale 1" = 40'

By Charles O. Georgi
REGISTERED LAND SURVEYOR

Description:

Lots 5 and 6 and West 5 feet of lot 4,
Block 2,
Robert's Vadnais View,
Subject to drainage easement over,
Said lot 6,
Ramsey County Minn.

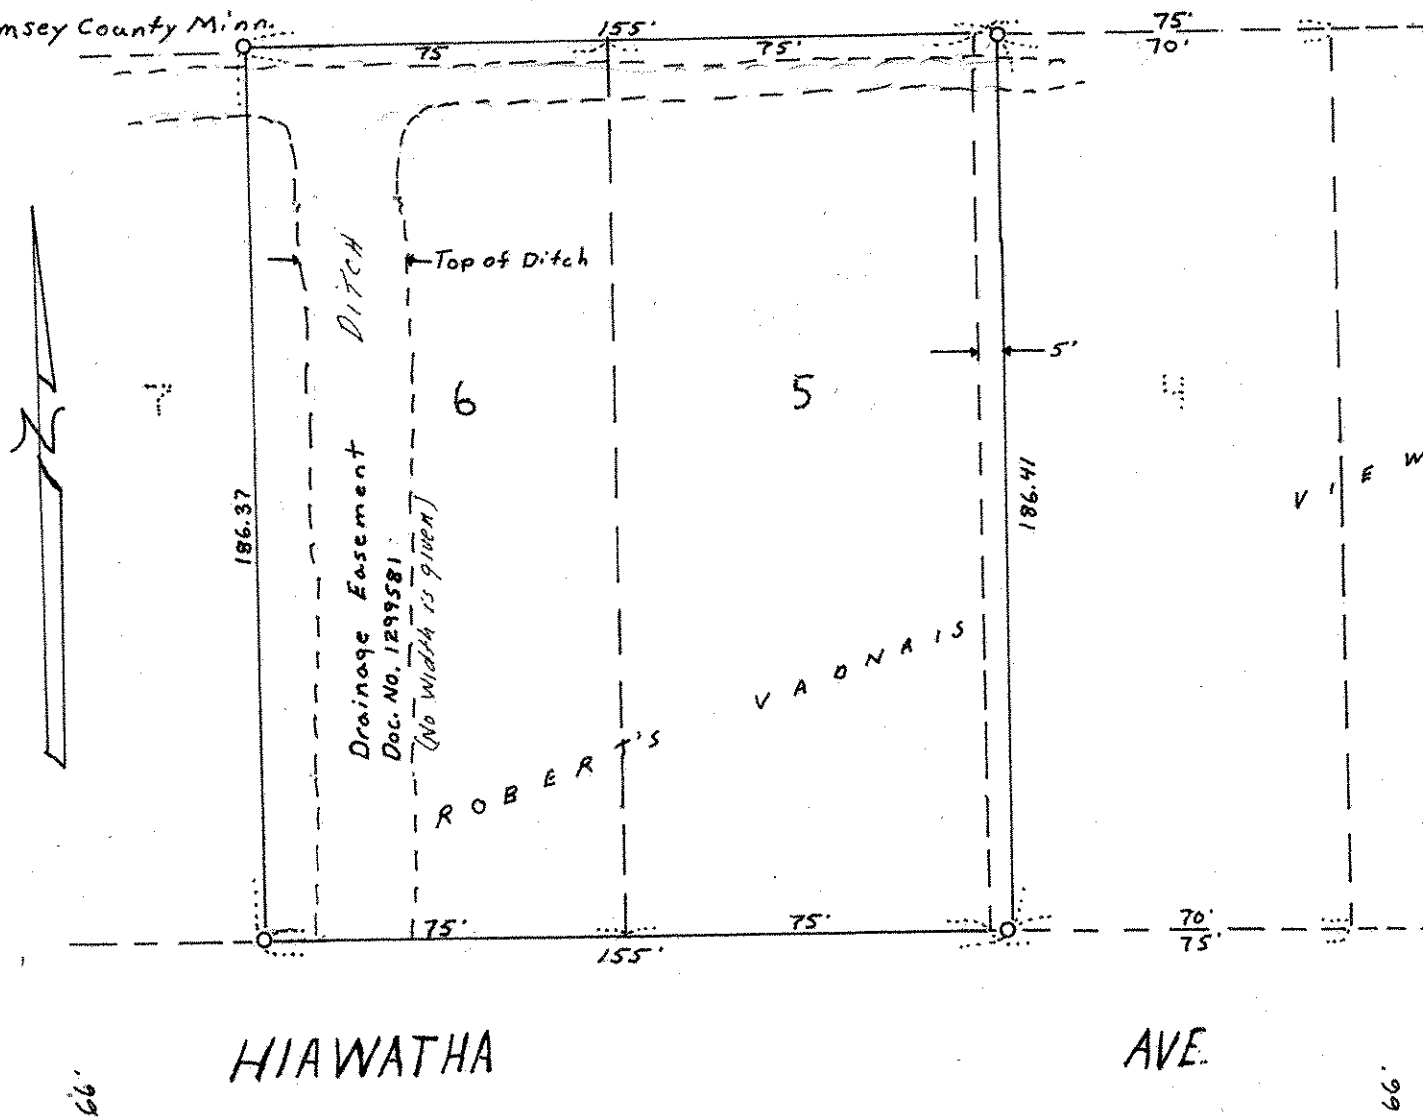

O Denotes Iron Monument