FROM THE OFFICE OF SW 33 30 22

CHARLES O. GEORGI COMPANY

2215 West County Road B Saint Paul 8, Minnesota

REGISTERED CIVIL ENGINEER AND LAND SURVEYOR

Certificate of Survey

I Hereby Certify that this plat shows a building location survey made by me on the property described on this plat, and that all locations, have been correctly shown.

Date November 1965

Scale 1" = 100'

By Charles O. Georgi
REGISTERED LAND SURVEYOR

Tom Rooney
Clifford Hawthorne

Description:
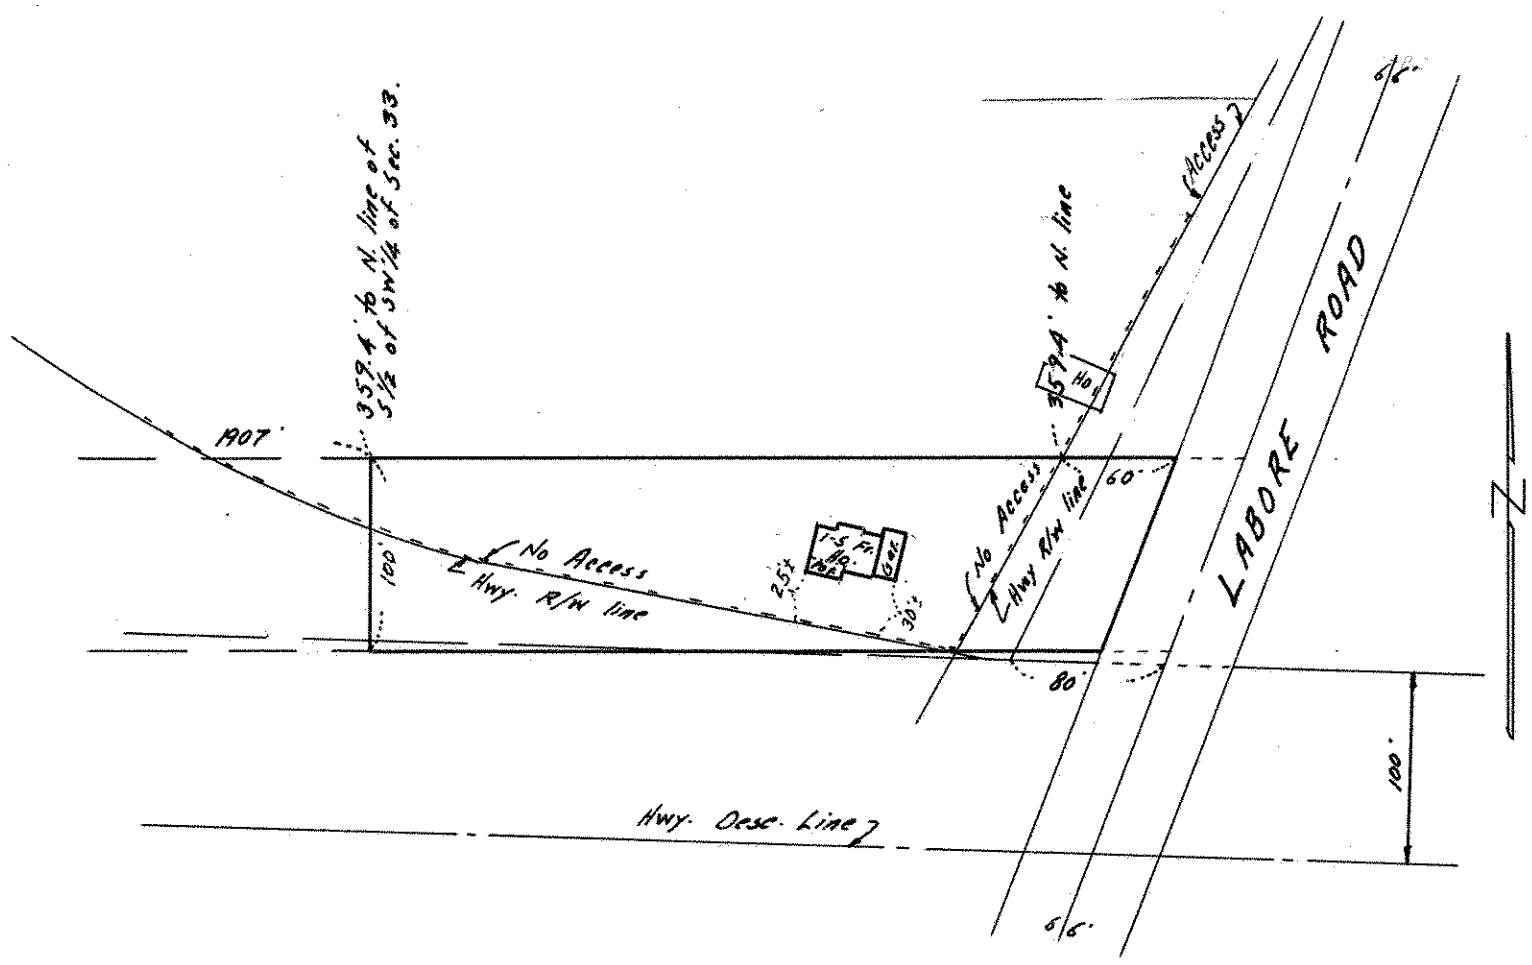
The South 100 feet of the North 459.4 feet of that part of the South 1/2 of the SW1/4 of Section 33, T30N, R22W, lying West of the center line of Labore Road and East of the West 1907 feet thereof, except that part taken for Highway purposes per Warranty Deed S.P. 6280 (390) 907 Neg. 35