NW 14 30 22

FROM THE OFFICE OF

CHARLES O. GEORGI COMPANY

2215 West County Road B Saint Paul, Minnesota 55113

REGISTERED CIVIL ENGINEER AND LAND SURVEYOR

Certificate of Survey

I Hereby Certify that **this plat shows a survey made by me of the property described on this plat, and that the corners are correctly placed as shown, and that all locations have been correctly shown.**

Surveyed For Eugene Glaraton

Date October 1974

Scale 1" = 30

By Donald W. Schmidt
REGISTERED LAND SURVEYOR

Description:
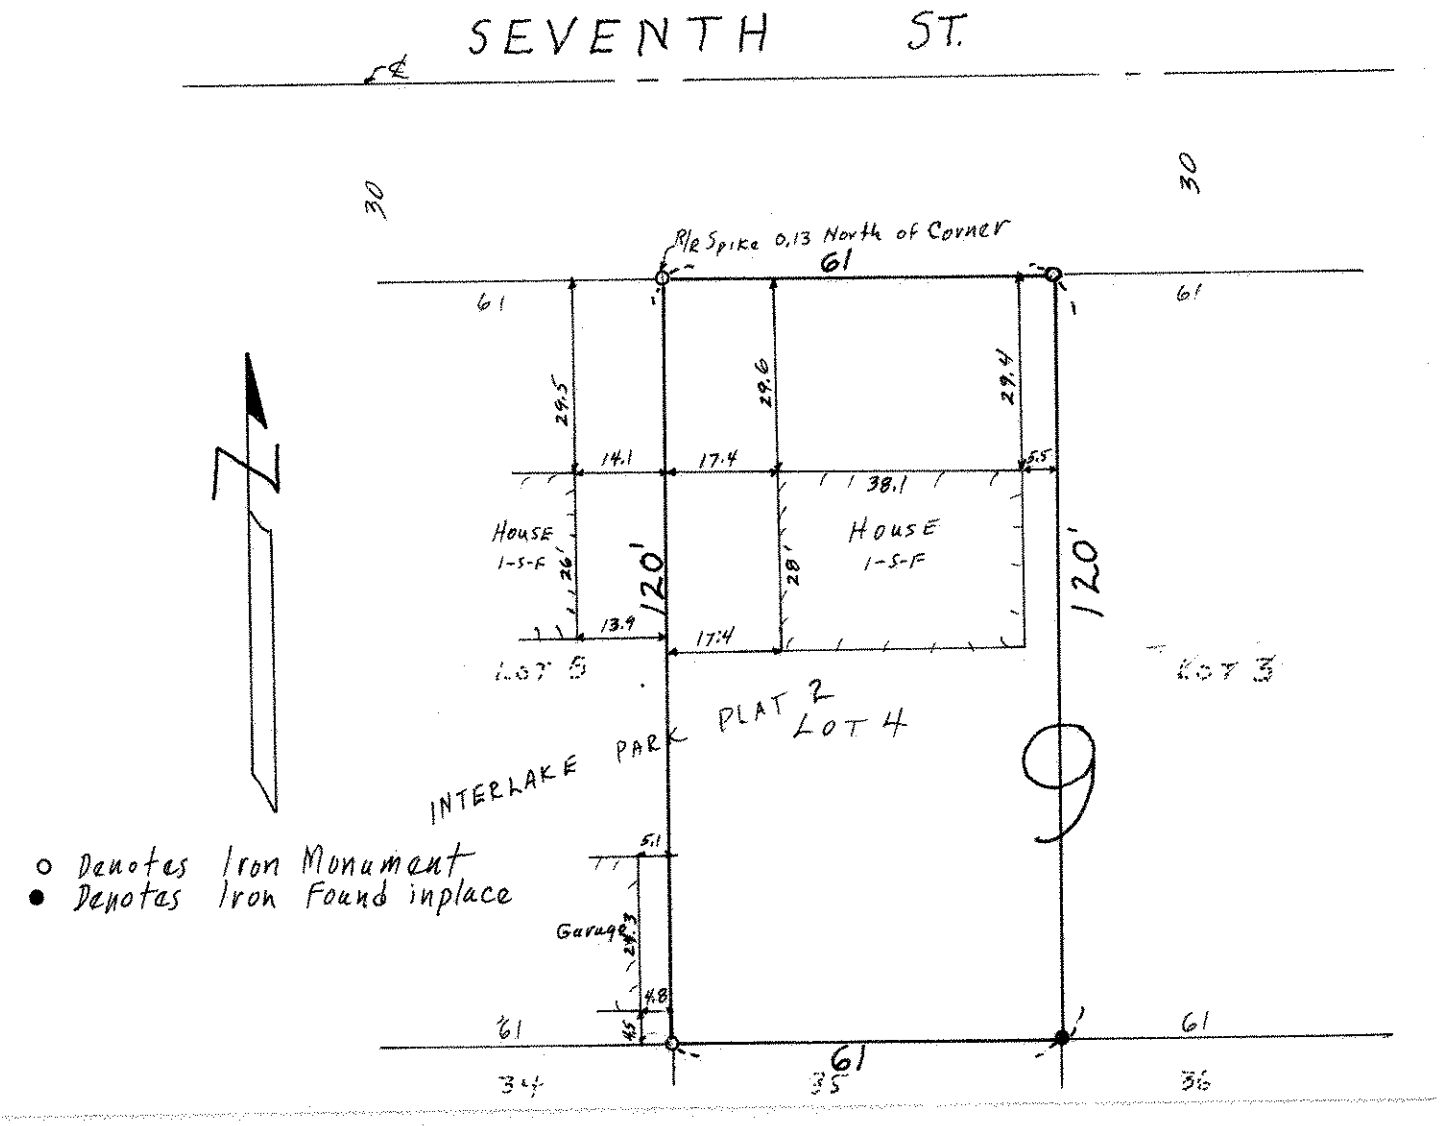
Lot 4, Block 9, Interlake Park Plat 2,
Ramsey County, Minnesota