Certificate

Job Number:

From the office of

## GEORGI- SCHMIDT & ASSOC. INC.

3092 No. Lexington Ave., Roseville, Mn. 55113 LAND SURVEYING

483-4408

I Hereby Certify that this plat shows a survey made by me of the property described on this plat, and that the corners are correctly placed as shown, and that all locations have been correctly shown.


Surveyed For Richard Ya Deau

Scale

Description:

Lot 13, Block 1, Red Fox HILLS

Ramsey County, Mr.

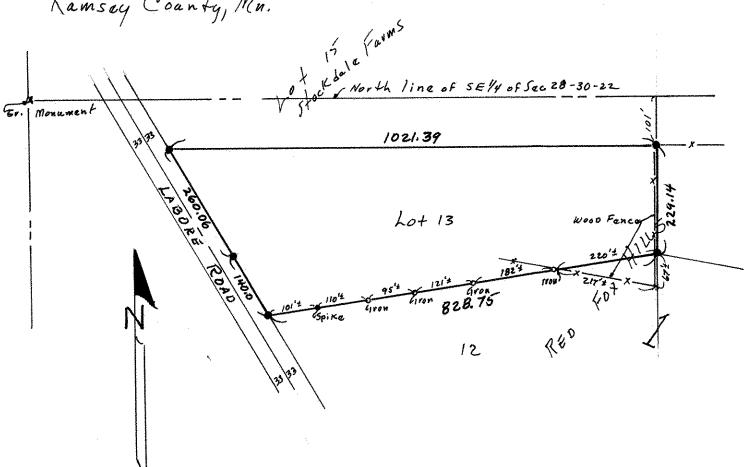

- · Danotes Irons found & Varified
- o Denotes Iron Monuments Sat