SW 29 30 22

Certificate of Survey

From the office of

GEORGI- SCHMIDT & ASSOC. INC.

3092 No. Lexington Ave., Roseville, Mn. 55113

LAND SURVEYING

483-4408

I Hereby Certify that this plat shows a survey made by me of the property described on this plat, ~~and that the corners are correctly placed as shown,~~ and that all locations have been correctly shown.

10/19/79 Set irons

Job Number: 376

Surveyed For Mike Krey

Date June 4, 1979

Scale 1" = 40'

By Donald W. Schmidt
REGISTERED LAND SURVEYOR

Description:

The South 137 feet of the North 627 feet of the East 153 feet of the SE¼ of the SW¼ of Section 29, T30N, R22W, subject to Edgerton Street over the East 33 feet thereof.

Ramsey County, Mn.

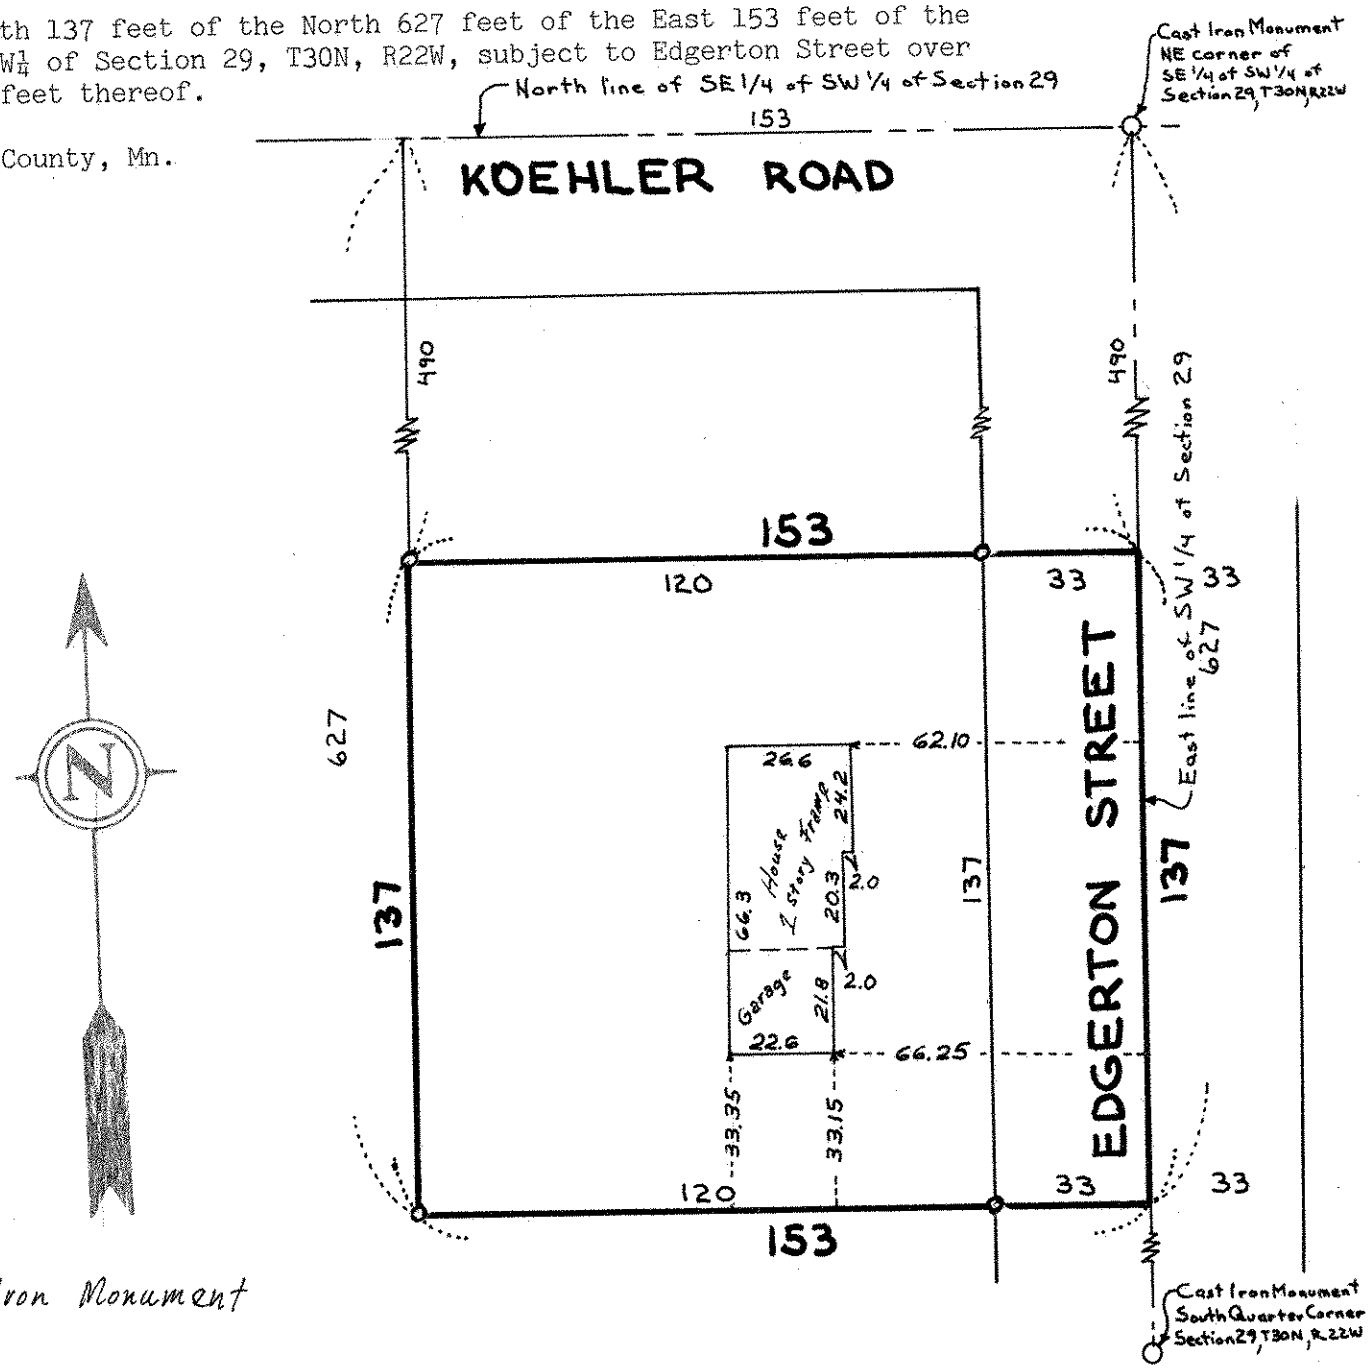

o Denotes Iron Monument