FROM THE OFFICE OF E½ 28 30 22

# CHARLES O. GEORGI COMPANY

2215 West County Road B · Saint Paul, Minnesota 55113

REGISTERED CIVIL ENGINEER AND LAND SURVEYOR

## Certificate of Survey

*I Hereby Certify that* this plat shows a survey made by me of the property described on this plat, and that the corners are correctly placed as shown, and that all locations have been correctly shown.

*Surveyed For* John J. Kenna

*Date* Nov. 1965

*Scale* 1" = 200'

By Charles O. Georgi
REGISTERED LAND SURVEYOR

*Description:*
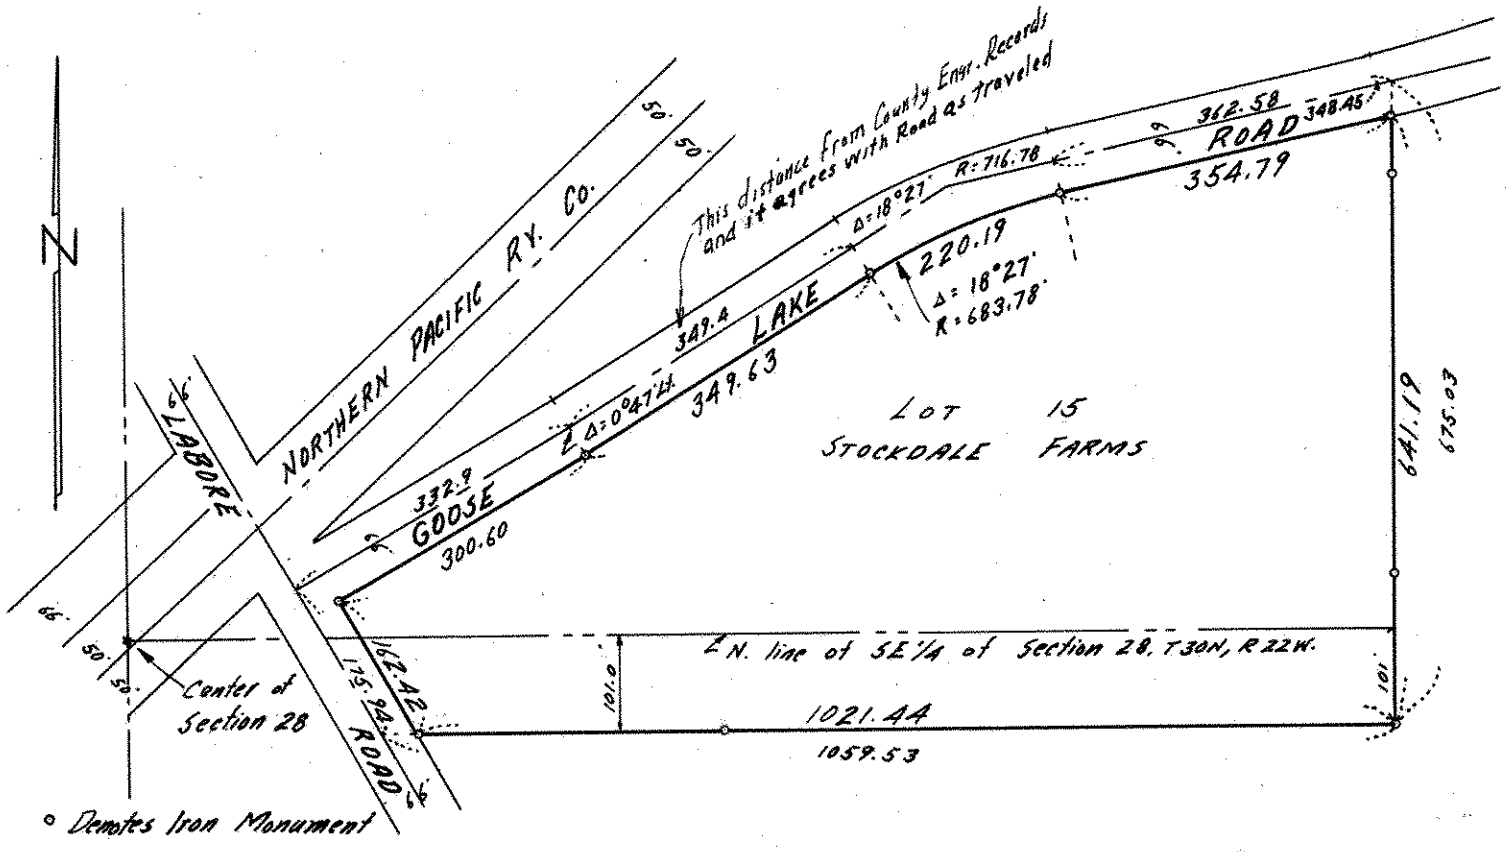
Lot 15, Stockdale Farms, Ramsey County, Minnesota, according to the plat thereof filed of record in the office of the Registrar of Titles within and for said county.
Also the North 101 feet of the West ½ of the North ½ of the North ½ of the SE¼ of Section 28, T30N, R22W, lying Easterly of the centerline of Labore Road.
Containing 11.00 Acres more or less.