SW 25 30 22

FROM THE OFFICE OF

CHARLES O. GEORGI COMPANY

2215 West County Road B — Saint Paul, Minnesota 55113

REGISTERED CIVIL ENGINEER AND LAND SURVEYOR

Certificate of Survey

I Hereby Certify that this plat shows a survey made by me of the property described on this plat, and that the corners are correctly placed as shown, and that all locations have been correctly shown. 7/13/74 Added House location C.O.G.

Surveyed For Richard Miner

Date May 1974

Scale 1" = 40'

By Charles O. Georgi
REGISTERED LAND SURVEYOR
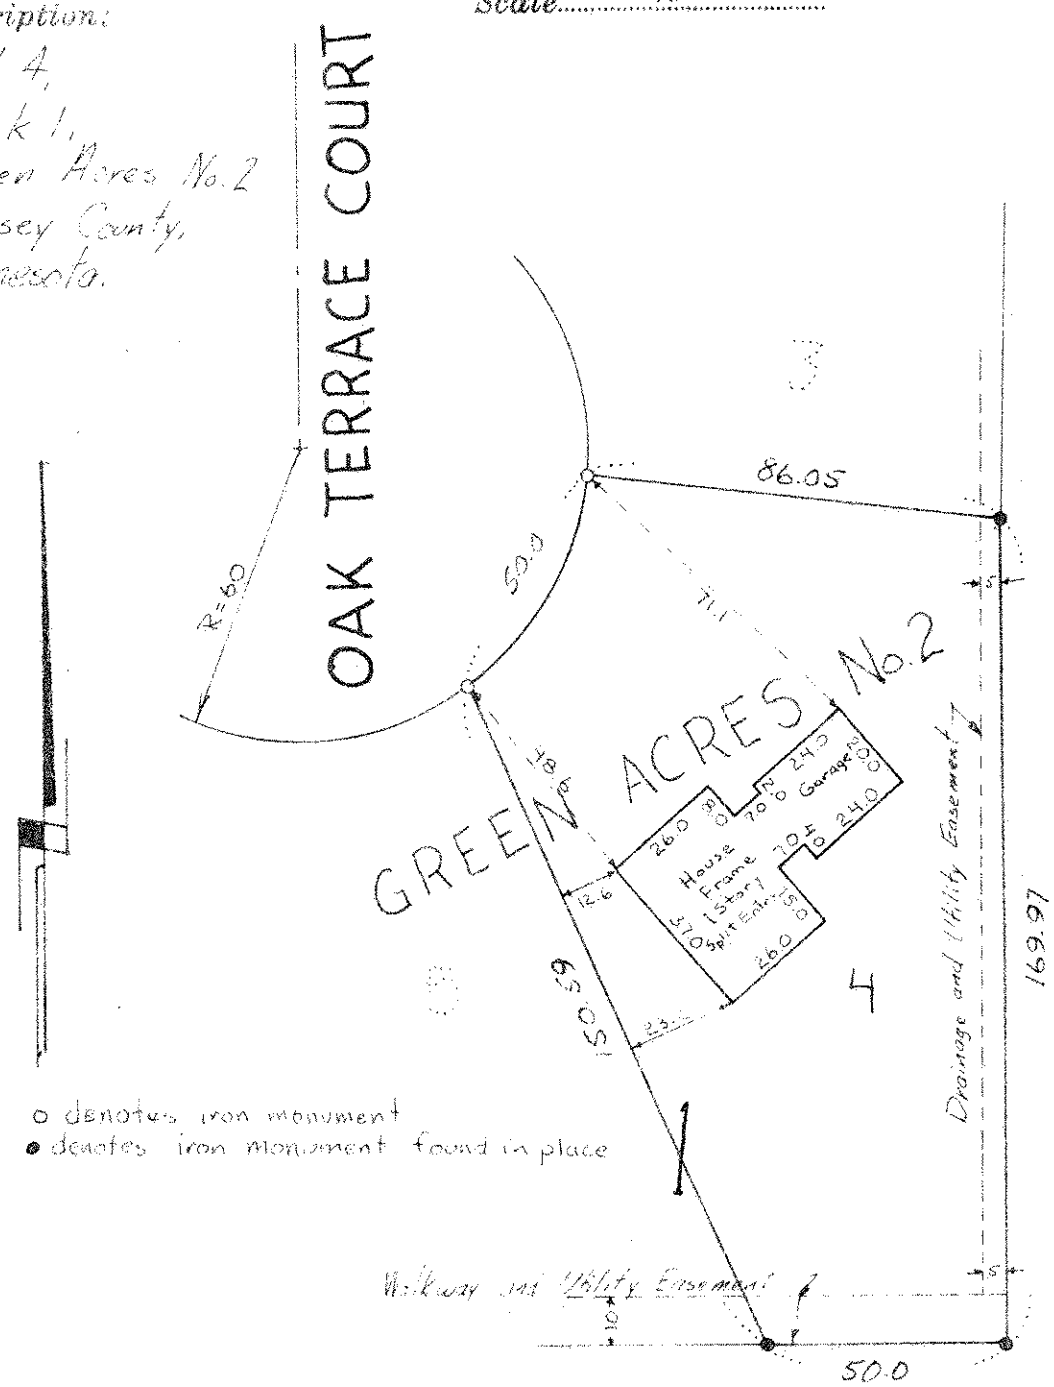
Description:
Lot 4,
Block 1,
Green Acres No. 2
Ramsey County,
Minnesota.