Certificate of Survey From the office of

GEORGI- SCHMIDT & ASSOC. INC.

3092 No. Lexington Ave., Roseville, Mn. 55113 LAND SURVEYING

483-4408

I Hereby Certify that this plat shows a survey made by me of the property described on this plat, and that the corners are correctly placed as shown, that this survey, plan or report was prepared by me, or under my direct supervision; and that I am a duly registered Land under the laws of the State of Minnesota.


ob Number:		dilder, the raws or the acade or utilities
surveyed For William	Pope	
)ate7/11/86		By
icale		Mn. Registration No. 10459

DESCRIPTIONS

Lot 17, Block 1, Green Acres

Ramsay County, MN.

· Denotes Iron Pipe Monument Set · Danotes Iron found inplace

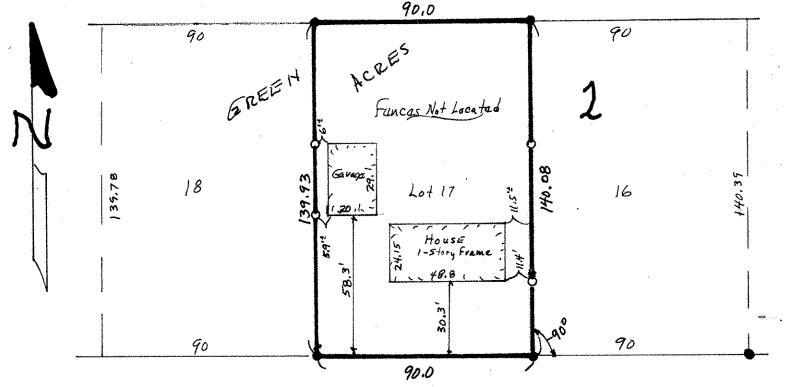

BIRCH STREET