## FROM THE OFFICE OF

## **CHARLES O. GEORGI COMPANY**

2215 West County Road B

Saint Paul, Minnesota 55113

REGISTERED CIVIL ENGINEER AND LAND SURVEYOR

I Hereby Certify that this plat shows a survey made by me of the property described on this plat, and that the corners are correctly placed as shown, and that all locations have been correctly shown.

Surveyed For Clyde Coulter

Date May 1975

Scale 1"=40'


By Mula Land Surveyor

Description:

Lot 16, Block 1, Bacchus Addition, Ramsey County, Minn.


Certificate

of Survey

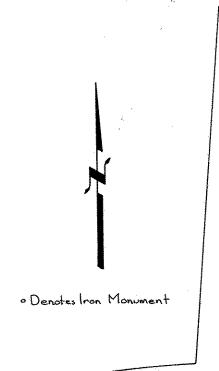

KENNY

60

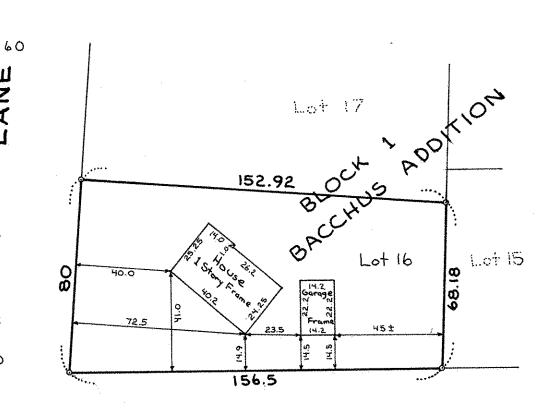

ODOROTHY

AVE.

09