

FROM THE OFFICE OF

CHARLES O. GEORGI COMPANY

2215 West County Road B

Saint Paul, Minnesota 55113

REGISTERED CIVIL ENGINEER AND LAND SURVEYOR



Certificate of Survey

I Hereby Certify that this plat shows a survey made by me of the property described on this plat, and that the corners are correctly placed as shown, and that all locations have been correctly shown.

File *White Bear Lake*

Surveyed For *City White Bear Lake (Frank Grayford)*



Date *May 1974*

Scale *1" = 40'*

By *Charles O. Georgi*
REGISTERED LAND SURVEYOR

Description:

*Lot 4,
Block 1,
Brookdale Park,
Ramsey County,
Minnesota.*

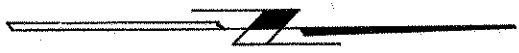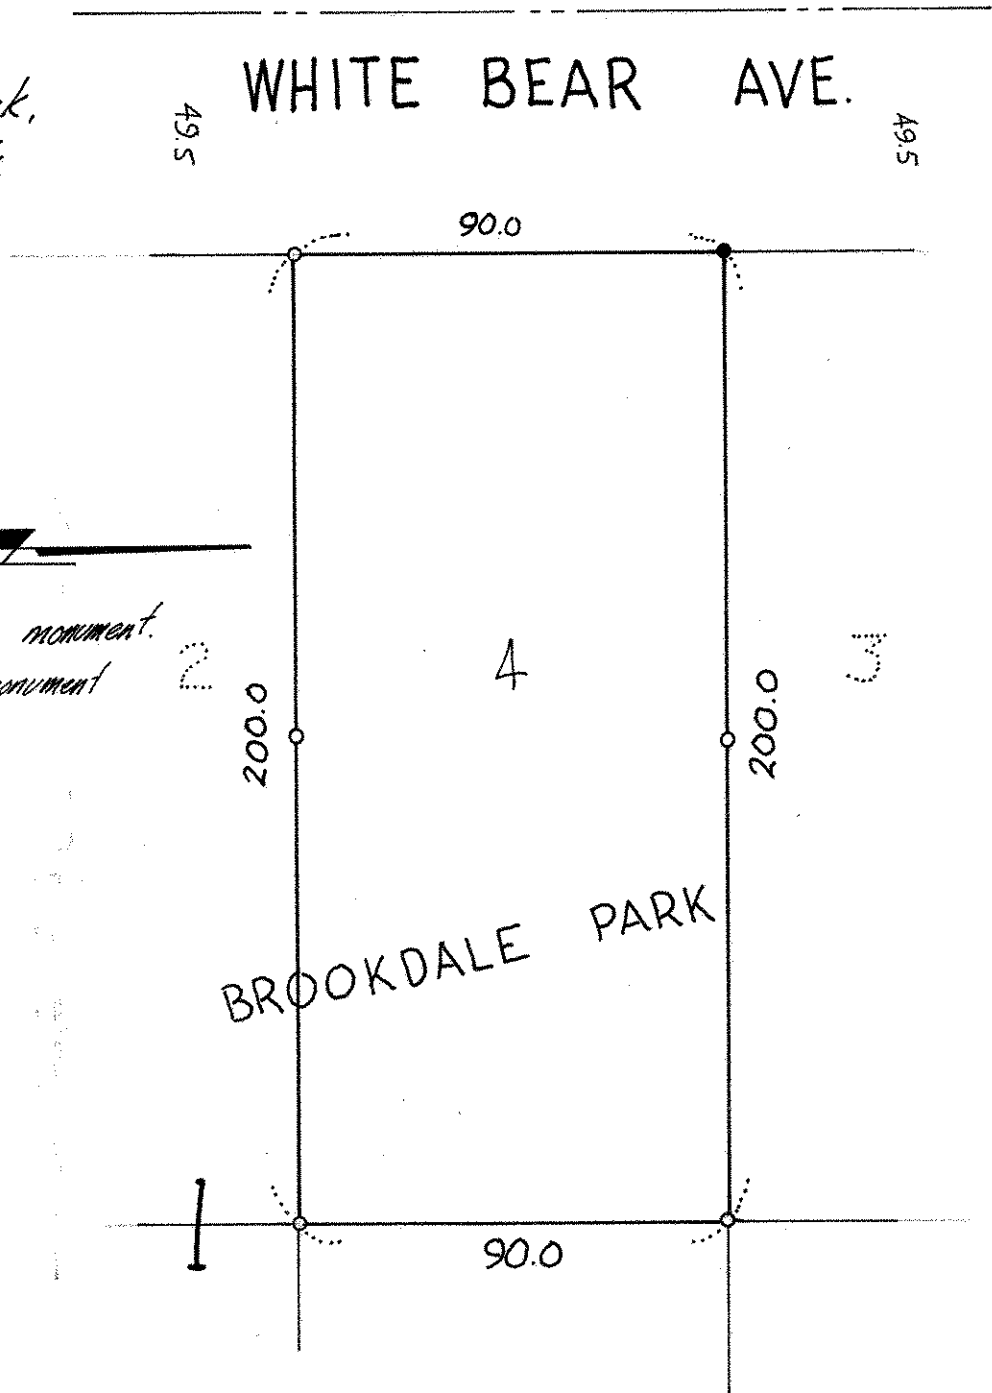

*o denotes iron monument.
• denotes iron monument
found in place.*