

FROM THE OFFICE OF

CHARLES O. GEORGI COMPANY

2215 West County Road B

Saint Paul 13, Minnesota

REGISTERED CIVIL ENGINEER AND LAND SURVEYOR

Certificate of Survey

I Hereby Certify that this plat shows a ^{location} survey made by me of the property described on this plat, ~~and that the corners are correctly placed as shown,~~ and that all locations have been correctly shown.

Surveyed For White Bear Lake Methodist Church


Date August 1965

Scale 1" = 200'

By Charles O. Georgi
REGISTERED LAND SURVEYOR

Description:

Lot 14 and 15
Block 5
Rearrangement of White Bear Park

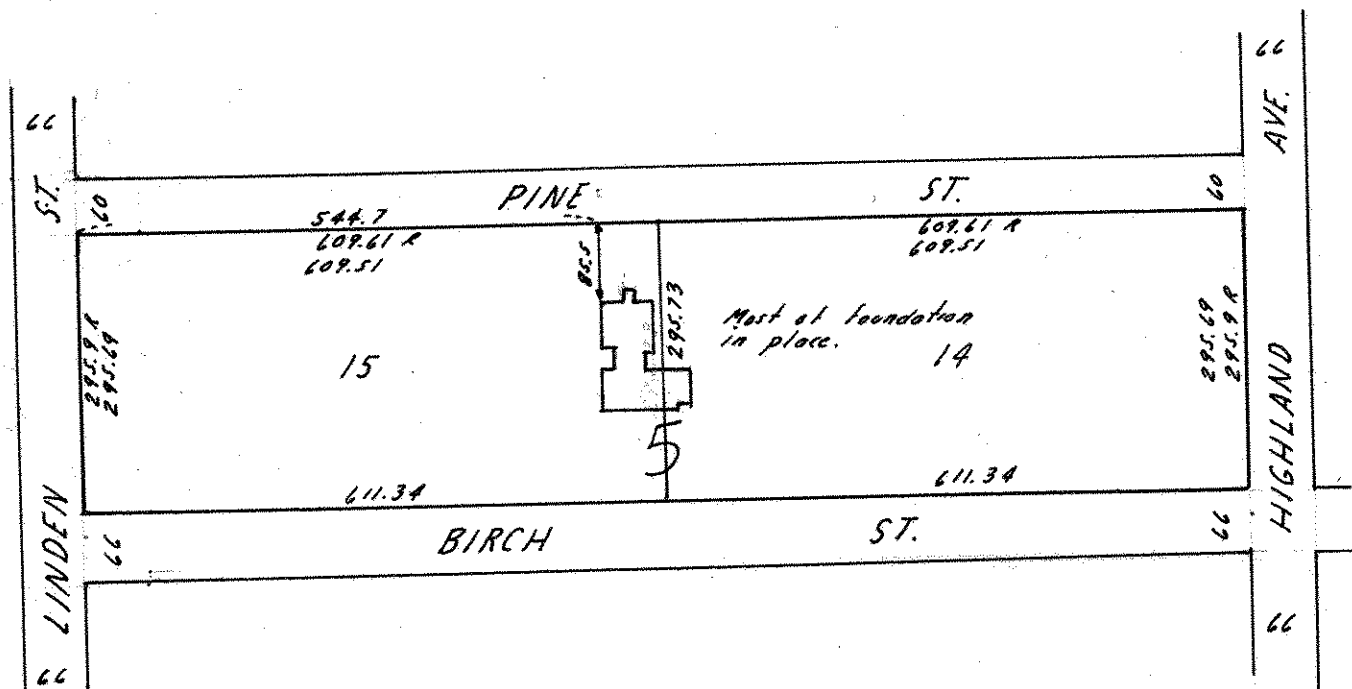

Note:
Boundary lines set July 1964 as shown on Site Map.