

FROM THE OFFICE OF

CHARLES O. GEORGI COMPANY

2215 West County Road B

Saint Paul, Minnesota 55113

REGISTERED CIVIL ENGINEER AND LAND SURVEYOR



**Certificate
of Survey**

I Hereby Certify that this plat shows a survey made by me of the property described on this plat, and that the corners are correctly placed as shown, and that all locations have been correctly shown.

Surveyed For *City of White Bear Lake*


Date *July 22, 1970*

Scale *1" = 200'*

By *Charles O. Georgi*
REGISTERED LAND SURVEYOR

Description:

*Lots 2 and 7, Block 9
Rearrangement of White Bear Park
Ramsey County, Minn*

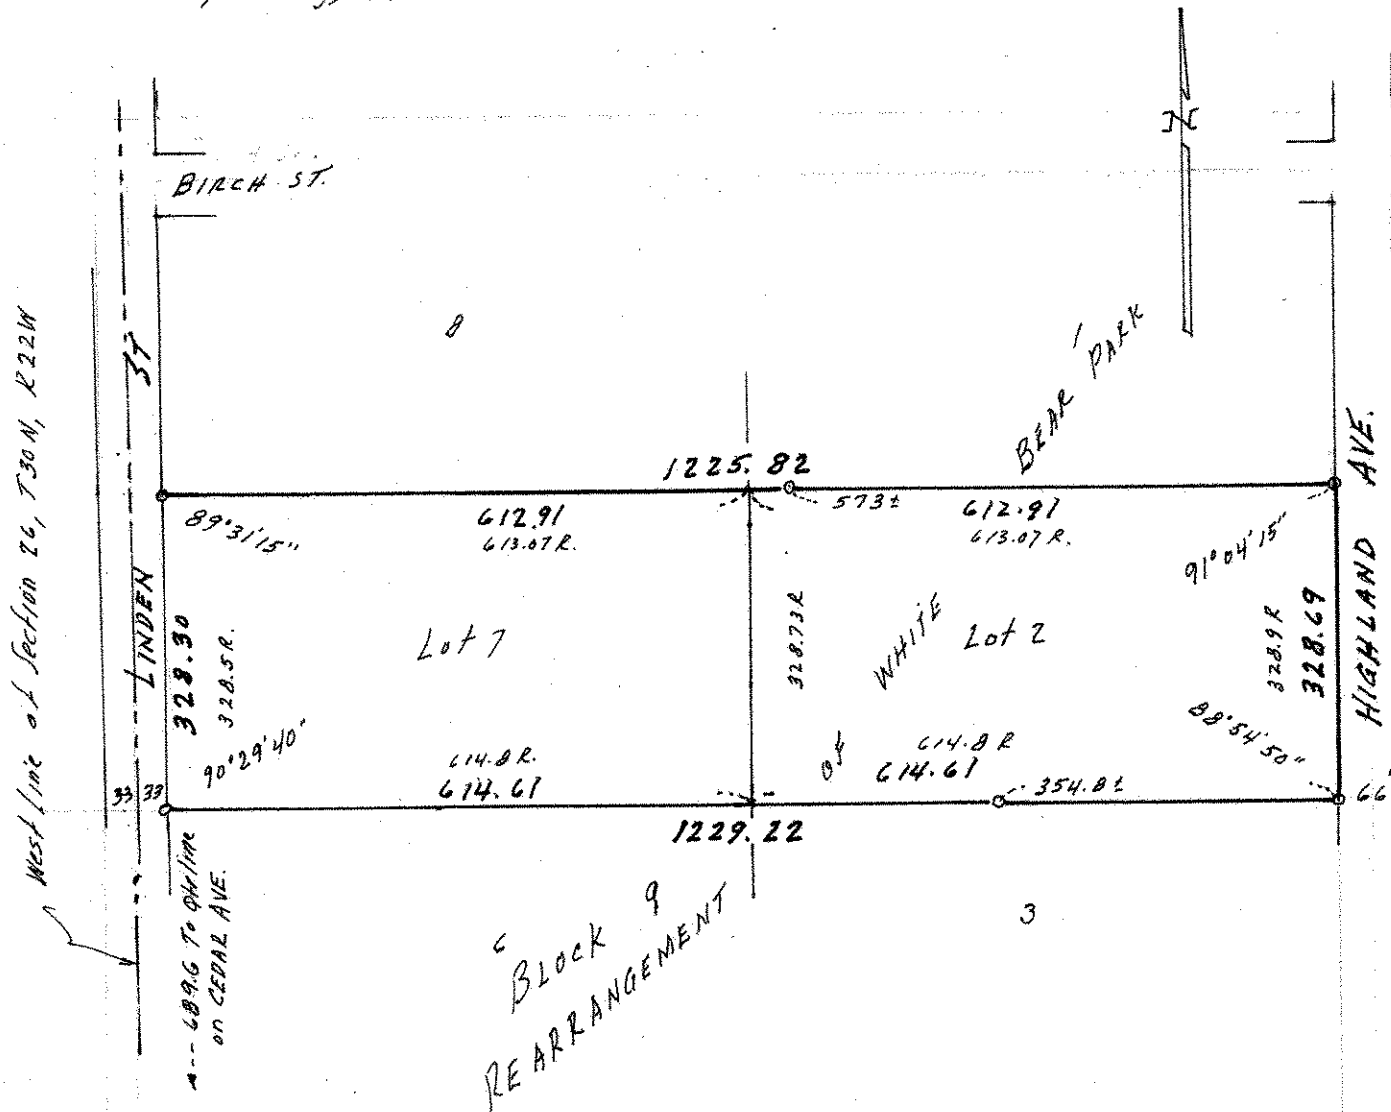

o Denotes Iron Pipe Movement.
R Denotes old record plat distance