SW 34 30 22

Certificate of Survey

From the office of

GEORGI- SCHMIDT & ASSOC. INC.

3092 No. Lexington Ave., Roseville, Mn. 55113
LAND SURVEYING
483-4408

I Hereby Certify that this plat shows a survey made by me of the property described on this plat, and that the corners are correctly placed as shown, that this survey, plan or report was prepared by me, or under my direct supervision; and that I am a duly registered Land Surveyor under the Laws of the State of Minnesota.

Job Number: 3399
Surveyed For G.N. Butler & Associates
Date 11/10/87
Scale 1"=50'

By _____
REGISTERED LAND SURVEYOR
Mn. Registration No. 10459

DESCRIPTION: (Contains 43,560 sq.ft., or one acre)
The Northerly 161.53 feet of the Southerly 484.59 feet of Lot 1, Block 1, Three-R-Industrial Park, Ramsey County, Minnesota, said lines measured parallel to the most Southerly line of said Lot 1, according to the recored plat thereof on file in the Office of the County Recorder in and for said County.
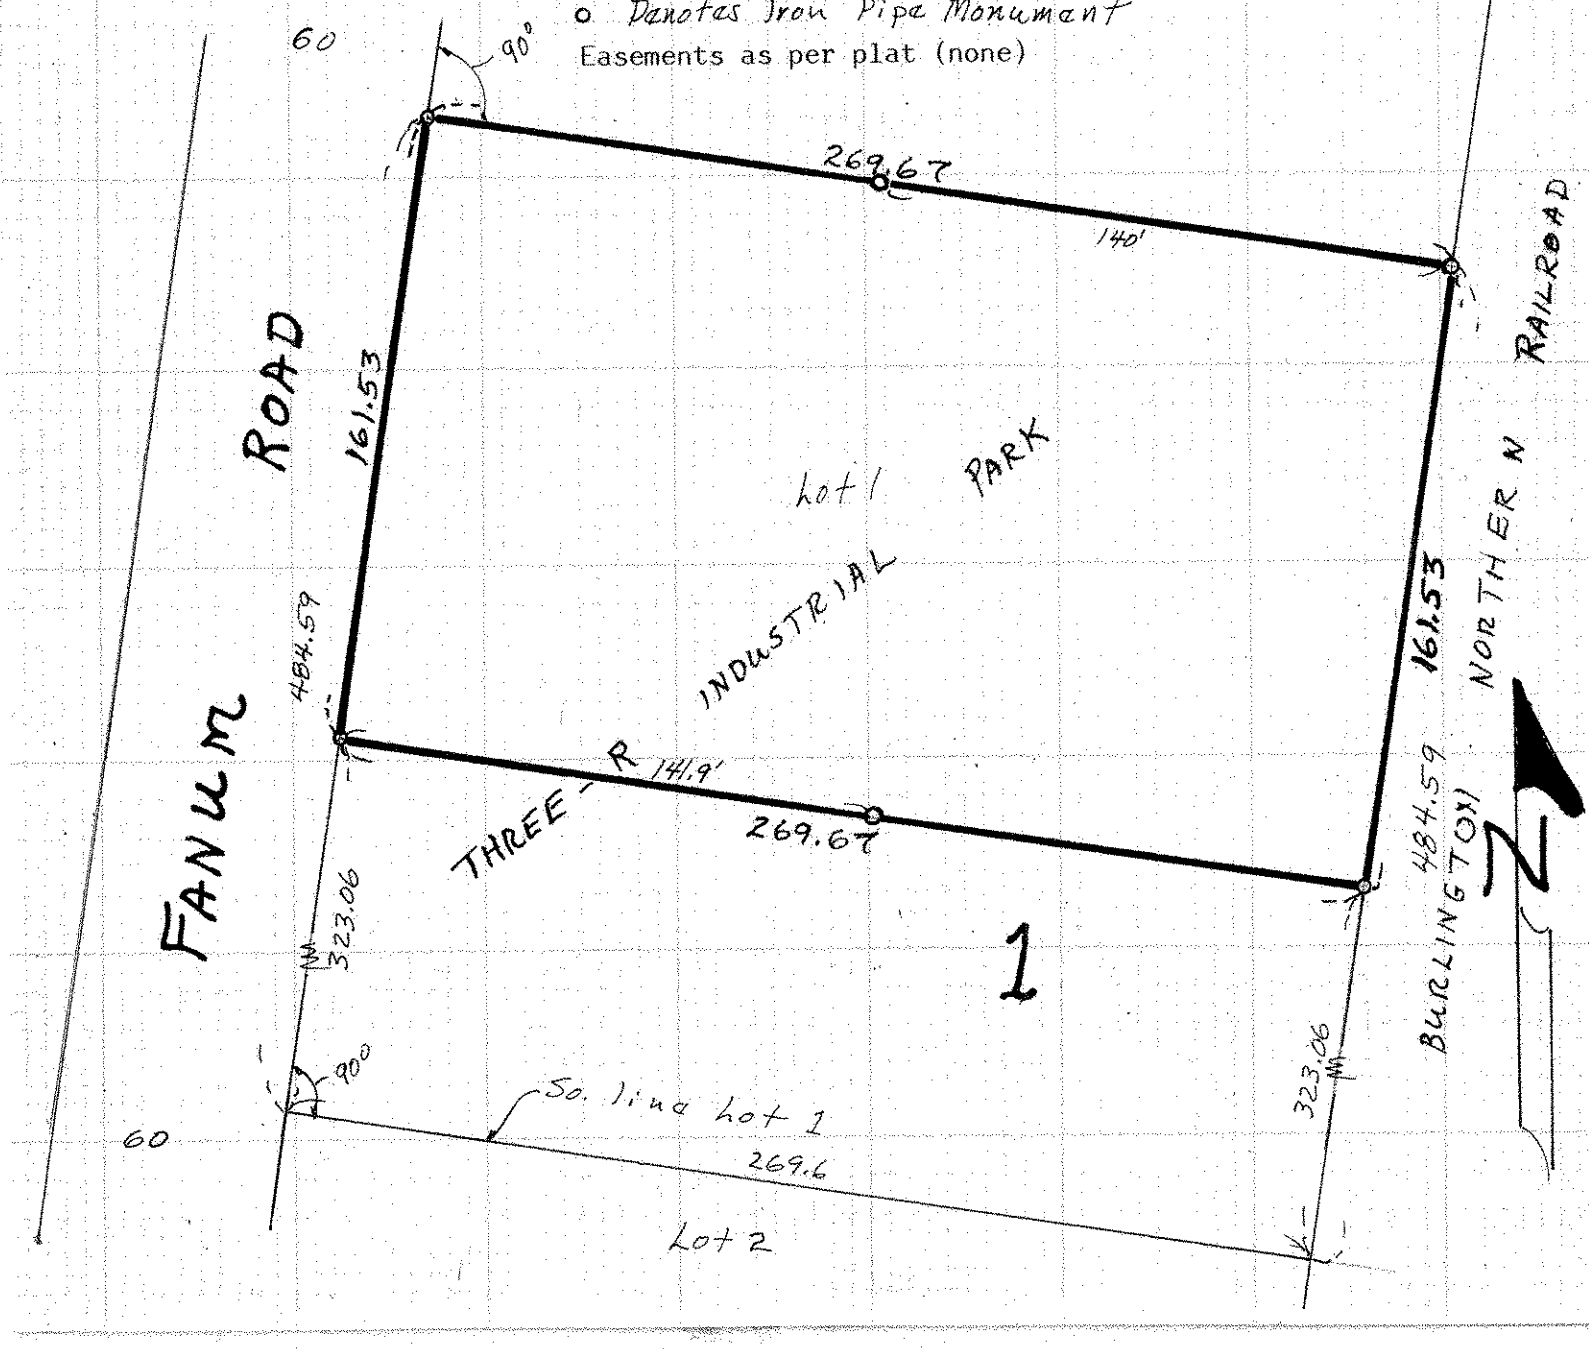
o Denotes Iron Pipe Monument
Easements as per plat (none)