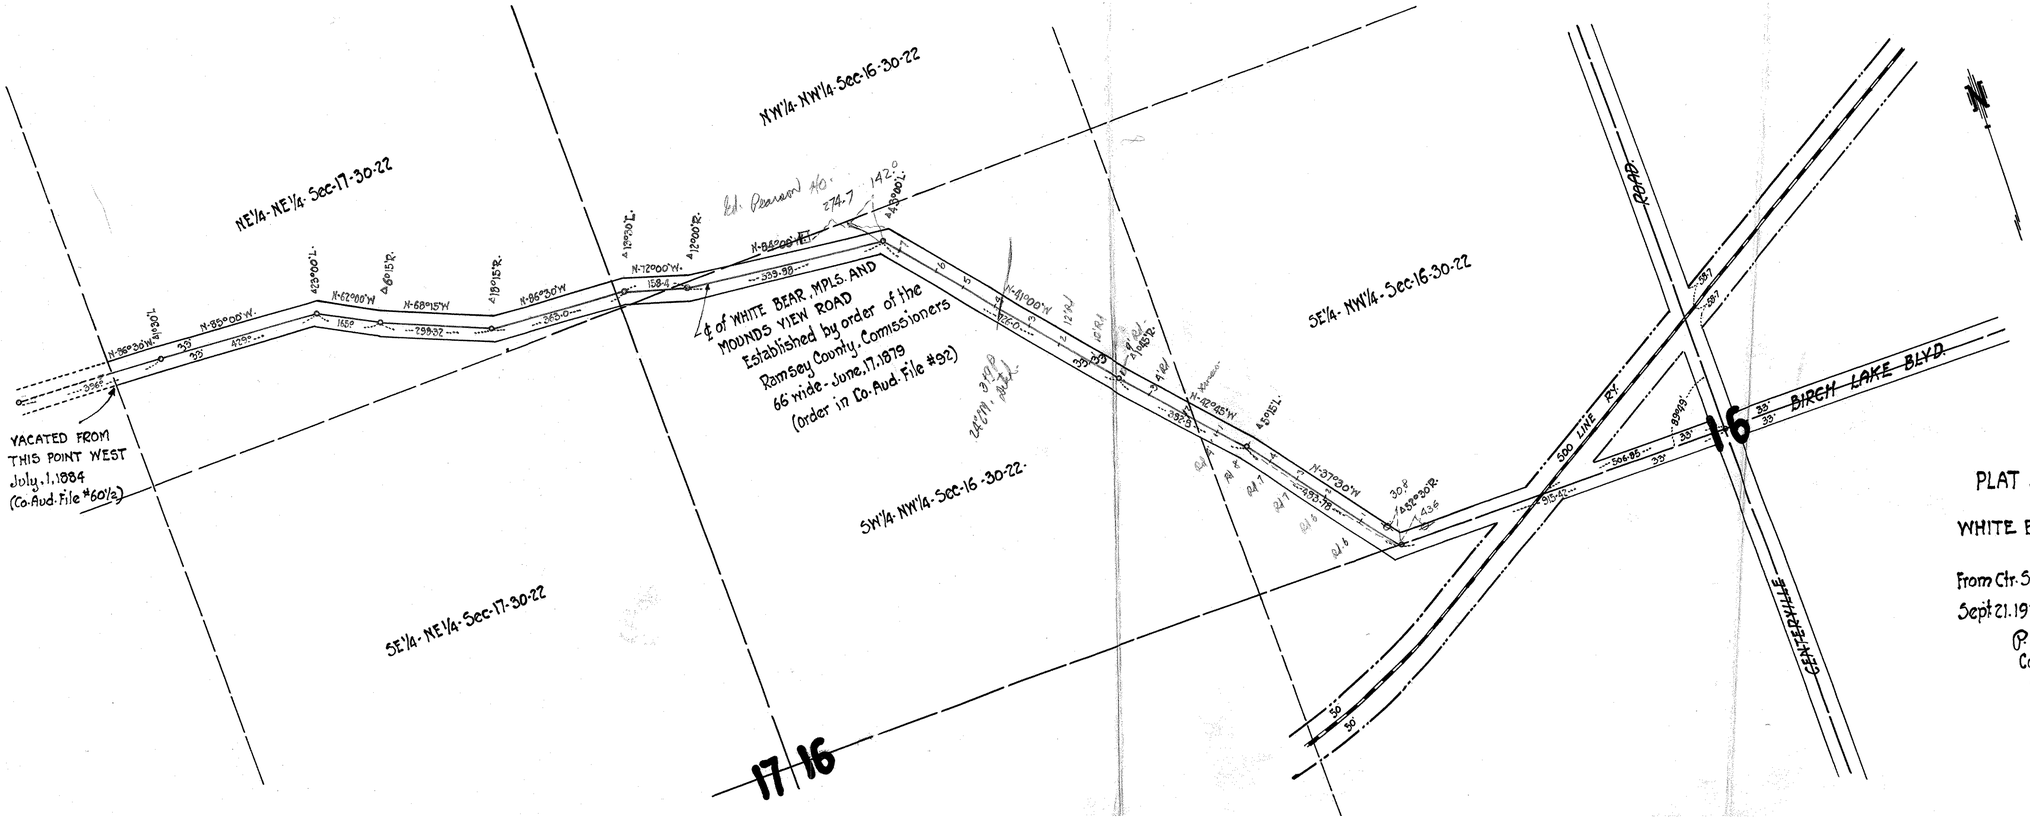

PLAT SHOWING LOCATION
OF
WHITE BEAR, MPLS. & MOUNDS VIEW ROAD
From Ctr. Sec. 16-30-22 to W. Line E½-NE¼-17-30-22
Sept 21. 1929 Scale - 1" = 200'

P. R. Banister
Consulting Engineer)
69-7th Ave. North St. Paul.