


Bacon & Coleman's Rice Street Acre Lots

SCALE 1-IN = 200 FT.

RECORDED SEPT. 14 - 1887

Book 9, P. 45
Surveyed by H. Phillips

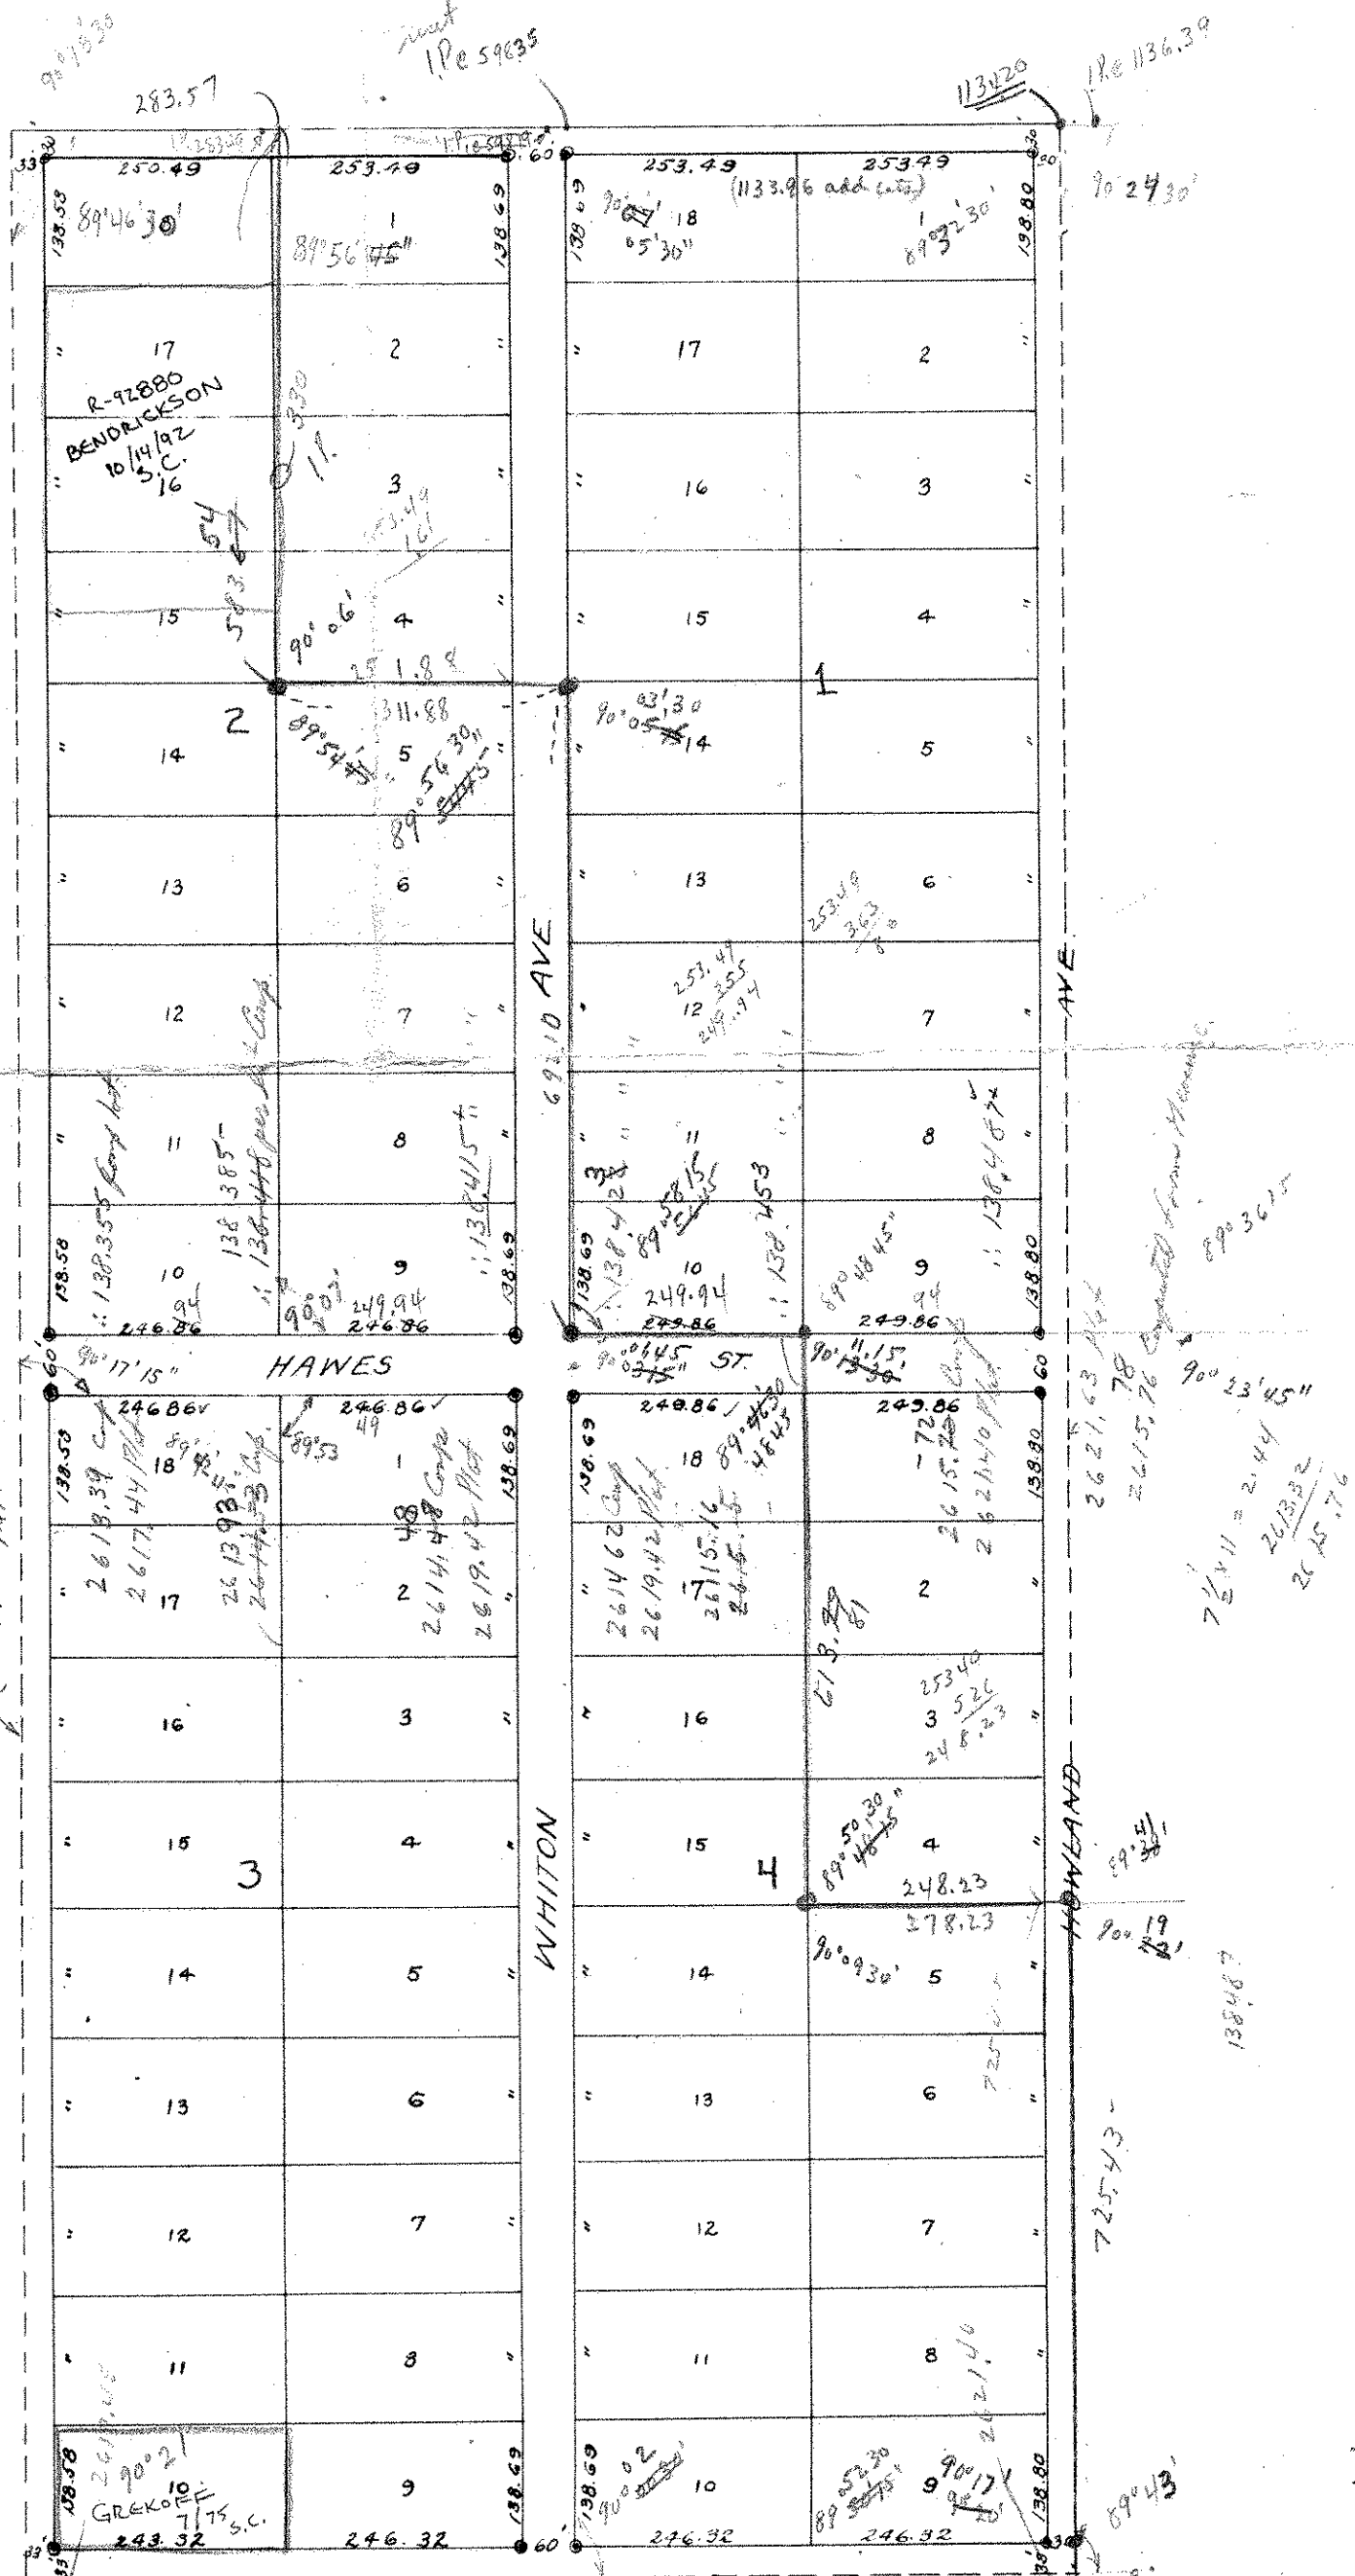

O INDICATES MONUMENTS

DESCRIPTION,
W. 1/2 of S. W. 1/4 Sec. 19 T. 30 N. R. 22 W.
All streets and alleys dedicated

33
243.32
246.32
60.37
246.33
30.
1105.7

1332 13.32
115 12.8
1407 14.60

16.10
18.7
17.00
19.72

IP.
117.85