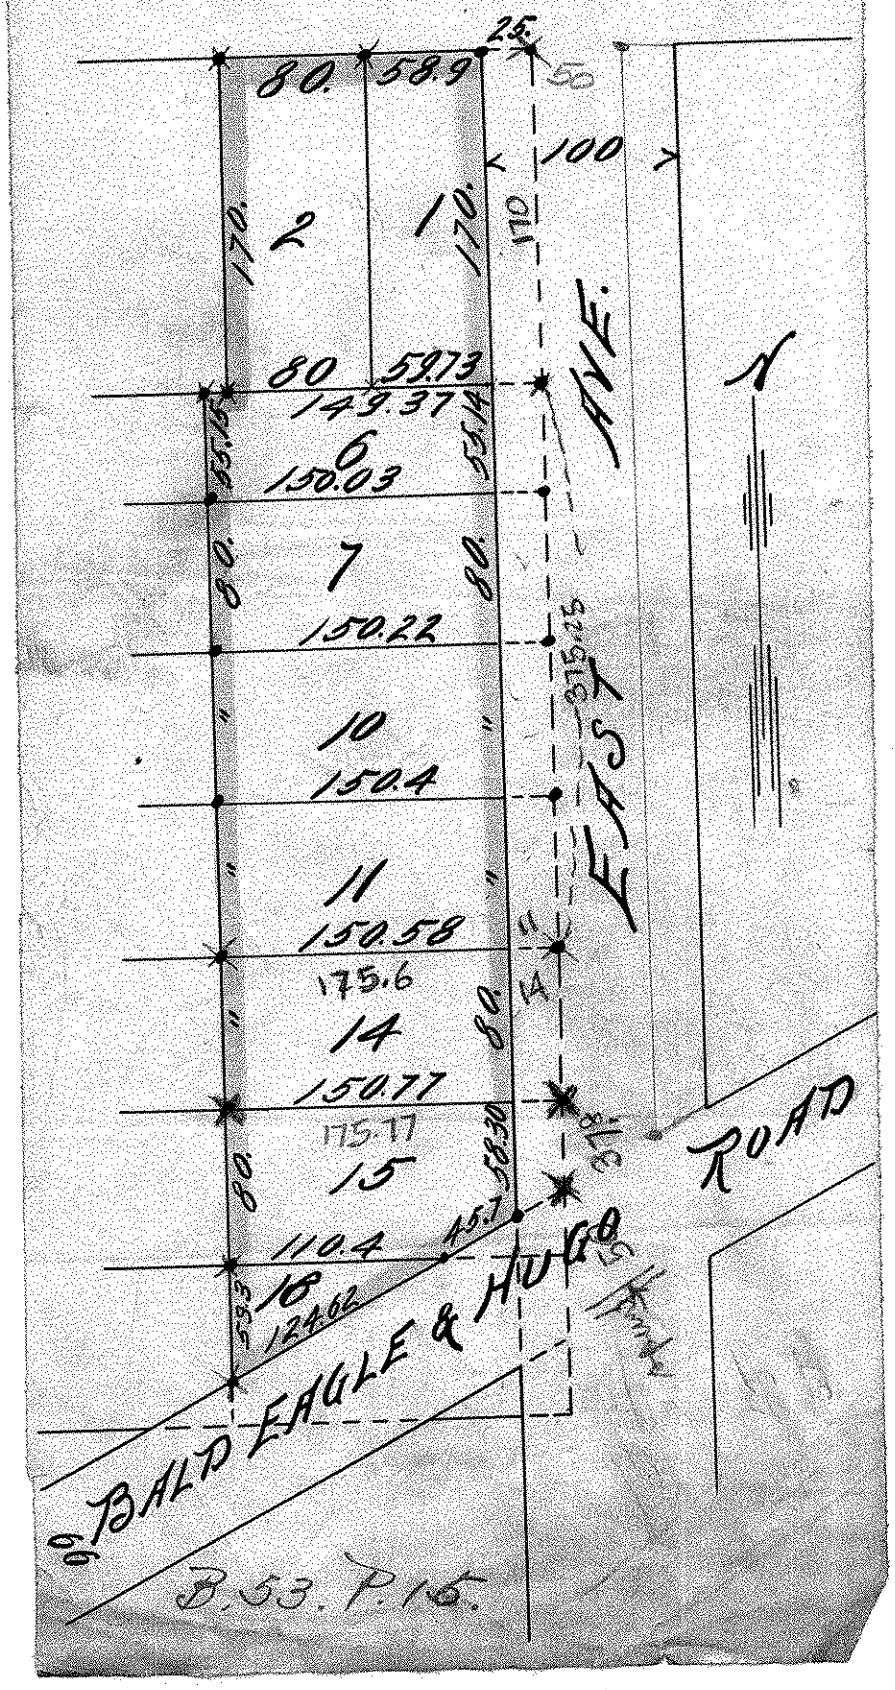LOTS 1.2.6.7.10.11.14.15 & 18
BLOCK 7 TOWN OF
BALD EAGLE.
SUR Oct. 20th 1902. 100'=1"
• indicates stake