

LOTS 22, 23, 24 & 25 BLOCK 1.

BELLAIRE,

WHITE BEAR LAKE.


JOHN B. IRVINE, SURVEYOR.

408 GLOBE BLDG.

ST PAUL, MINN.

MAY 6-1913

scale 40 ft. per inch.

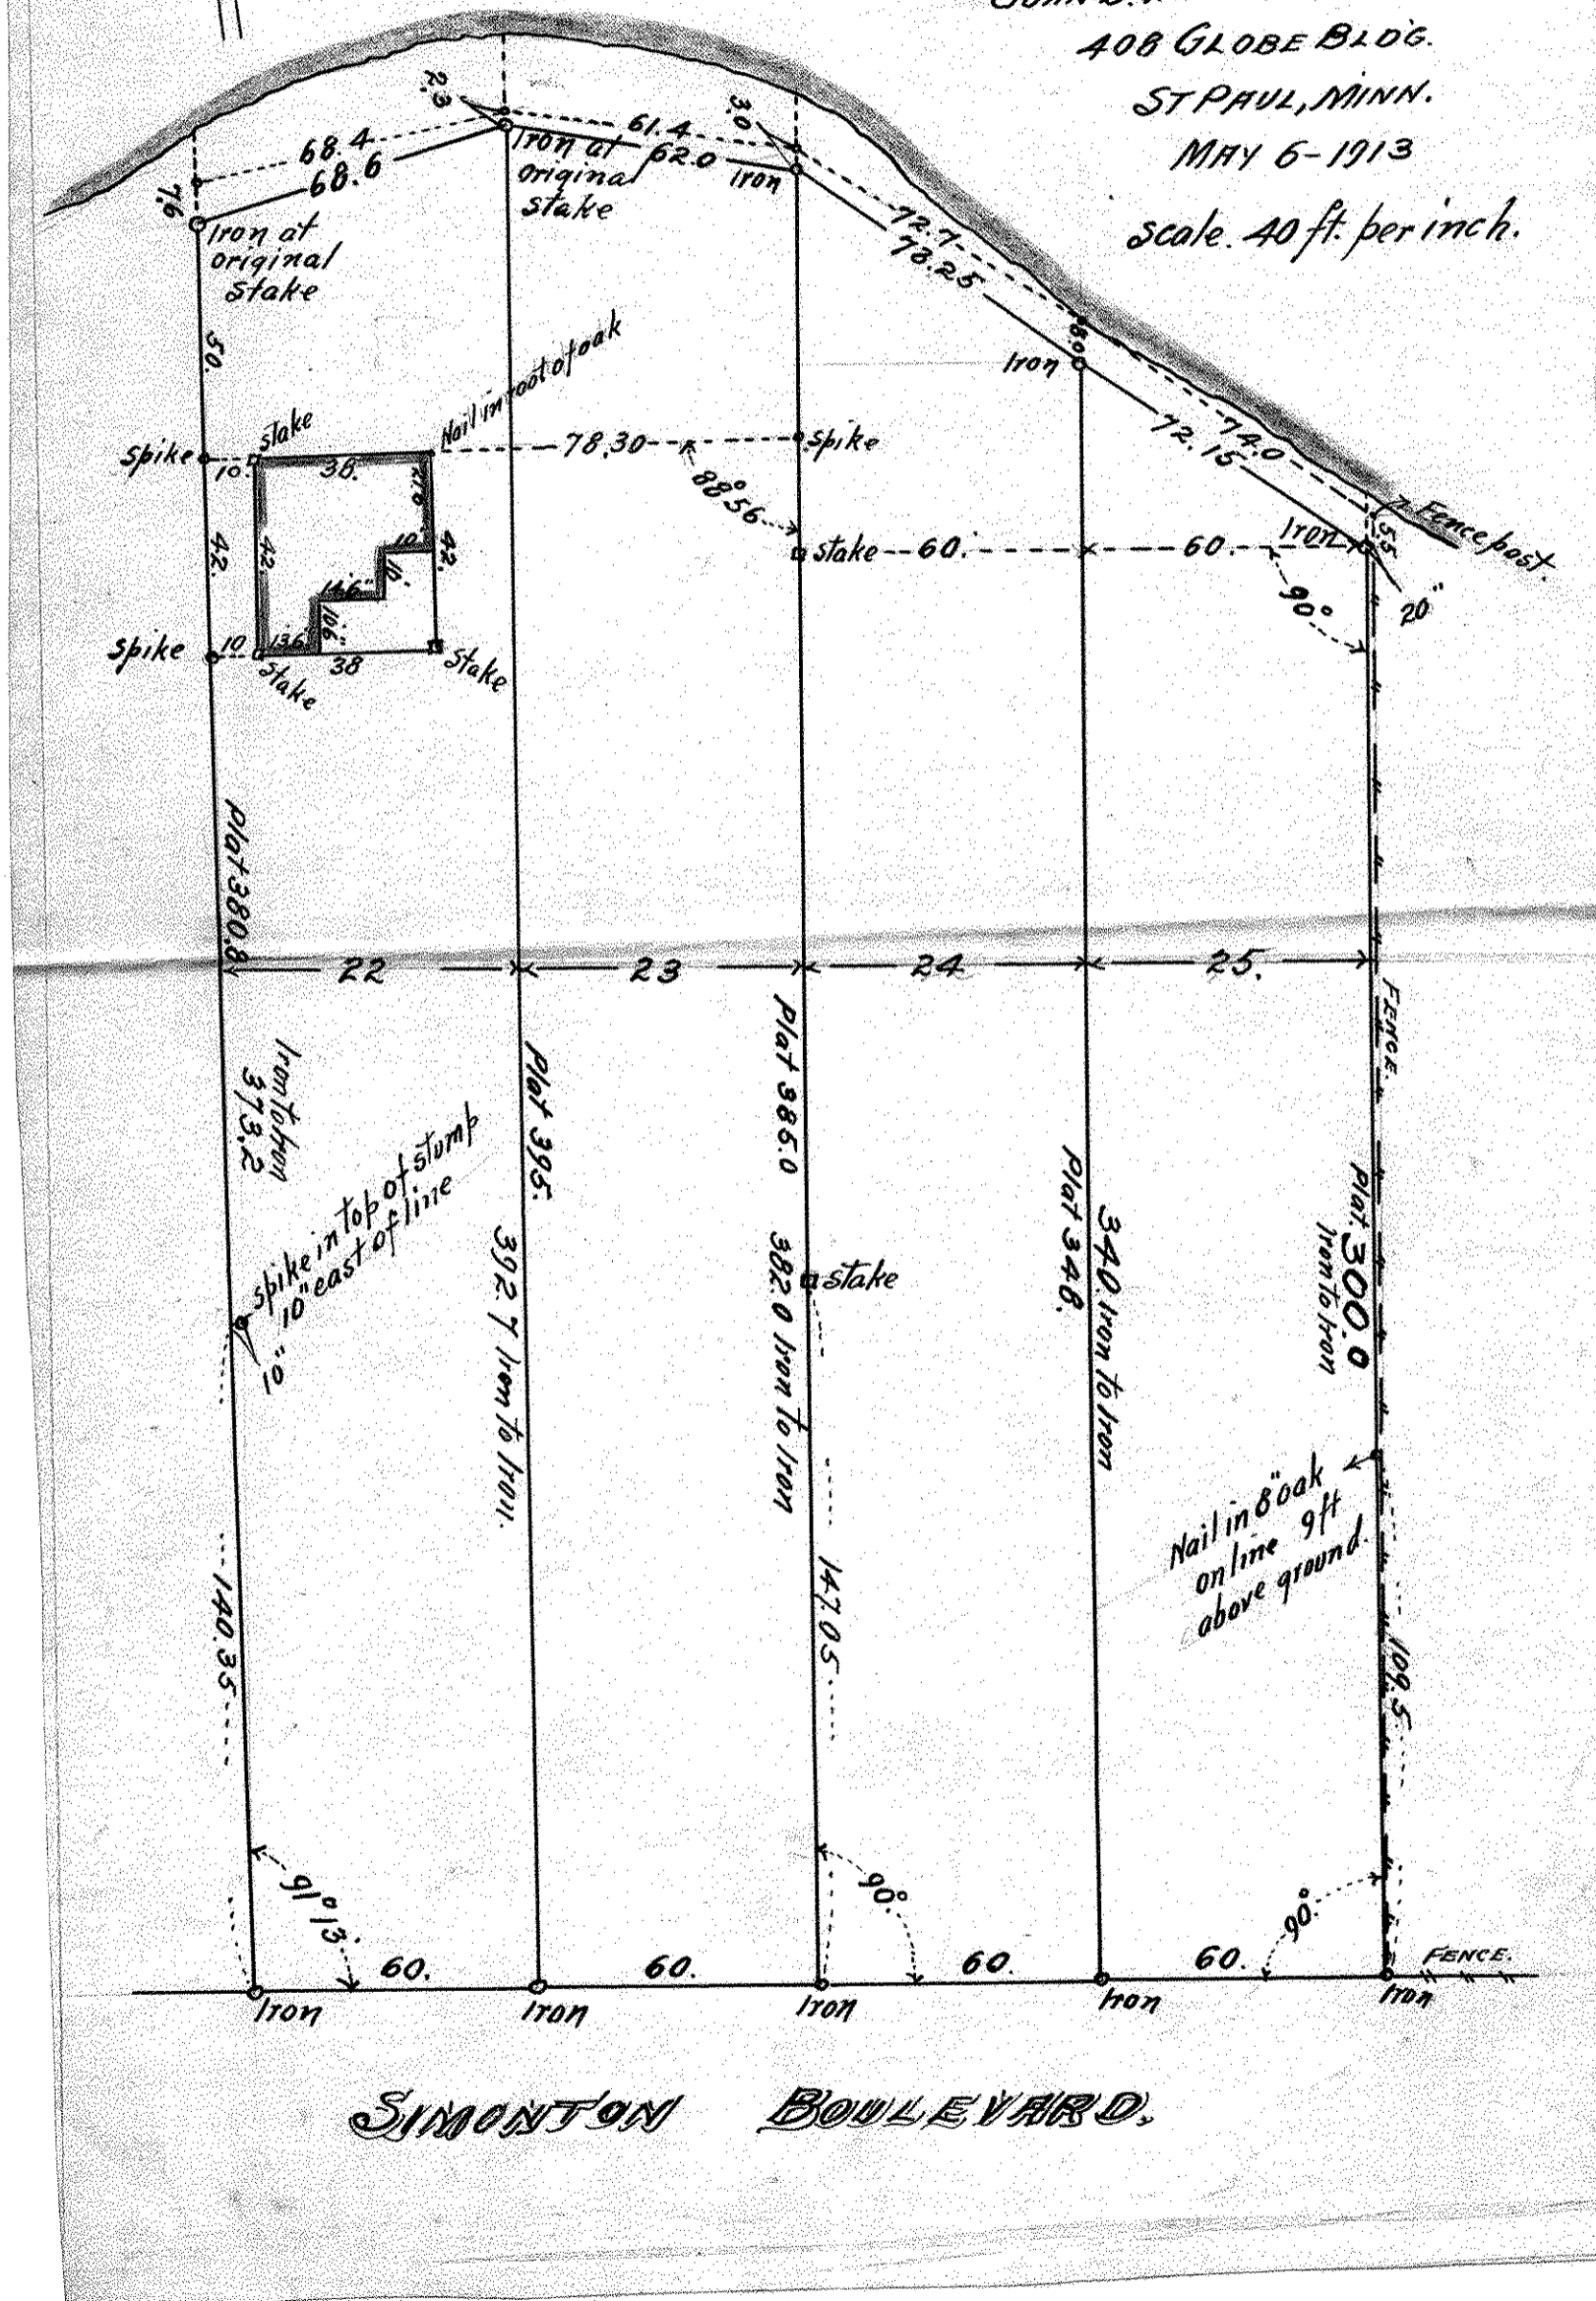

SIMONTON BOULEVARD.