SE 23 30 22

FROM THE OFFICE OF

CHARLES O. GEORGI COMPANY

2215 West County Road B Saint Paul, Minnesota 55113

REGISTERED CIVIL ENGINEER AND LAND SURVEYOR

Certificate of Survey

I Hereby Certify that **this plat shows a survey made by me of the property described on this plat, and that the corners are correctly placed as shown, and that all locations have been correctly shown.**

Surveyed For John Herbert

Date April 1976

Scale 1" = 40'

By Charles O. Georgi
REGISTERED LAND SURVEYOR

Description:

The West ½ of Vacated South Shore Ave. adjoining and the North ½ of vacated alley adjoining and lot 11, Block 2, South Shore Addition, Ramsey County, Minnesota.

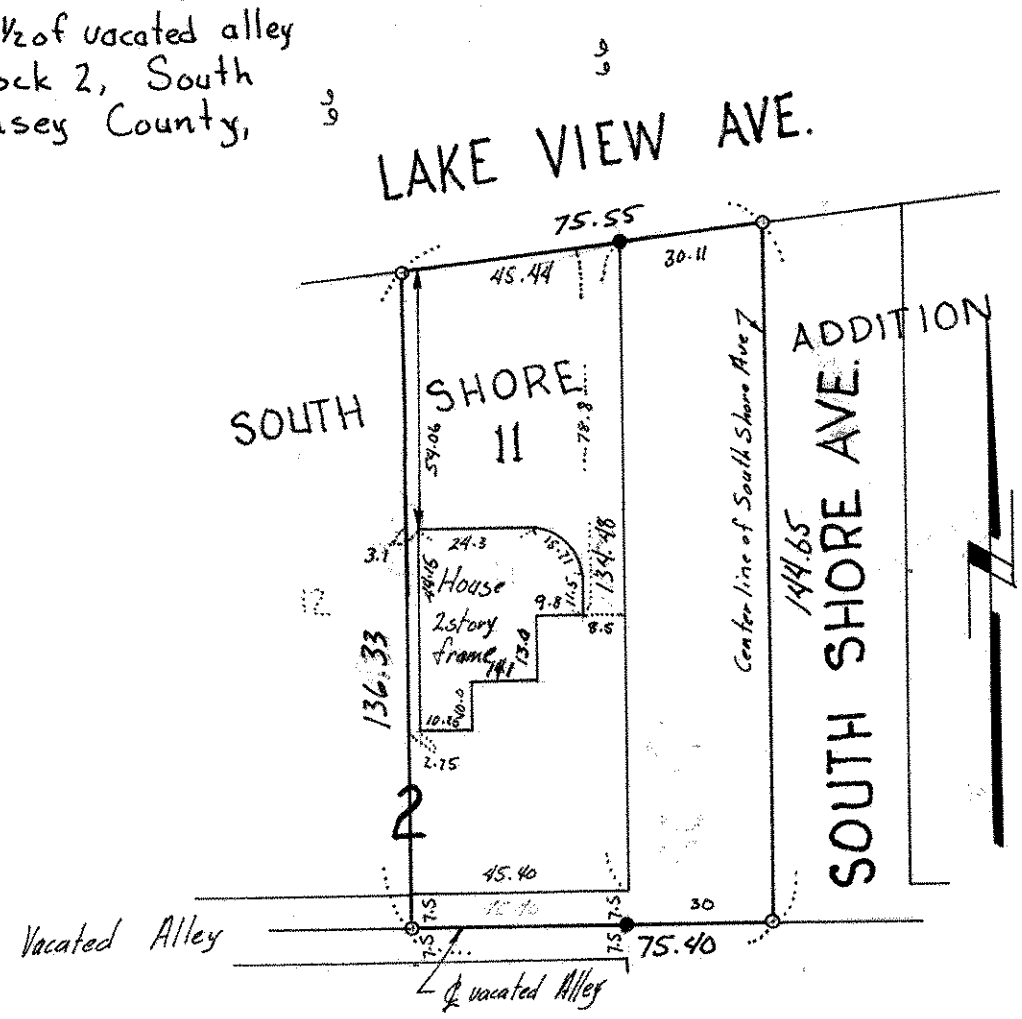

● denotes iron pipe monument found in place

o denotes iron pipe monument.