

NW 14 3022

FROM THE OFFICE OF

CHARLES O. GEORGI COMPANY

2215 West County Road B

Saint Paul, Minnesota 55113

REGISTERED CIVIL ENGINEER AND LAND SURVEYOR



Certificate of Survey

I Hereby Certify that this plat shows a survey made by me of the property described on this plat, and that the corners are correctly placed as shown, and that all locations have been correctly shown.

Surveyed For William Henricks

Date August 1970

Scale 1"=100'

By Charles O. Georgi
REGISTERED LAND SURVEYOR

Description: Total

The South 126.59 feet of Lot 5,
Auditor's Subdivision No 49
Ramsey County, Minn.


DESCRIPTION: (Parcel A)

The East 204.0 feet of the South 126.59 feet of Lot 5, Auditor's Subdivision No. 49
Ramsey County, Minnesota

DESCRIPTION: (Parcel B)

The South 126.59 feet of Lot 5, Auditor's Subdivision No. 49,
except the East 204.0 feet thereof.

Ramsey County, Minnesota

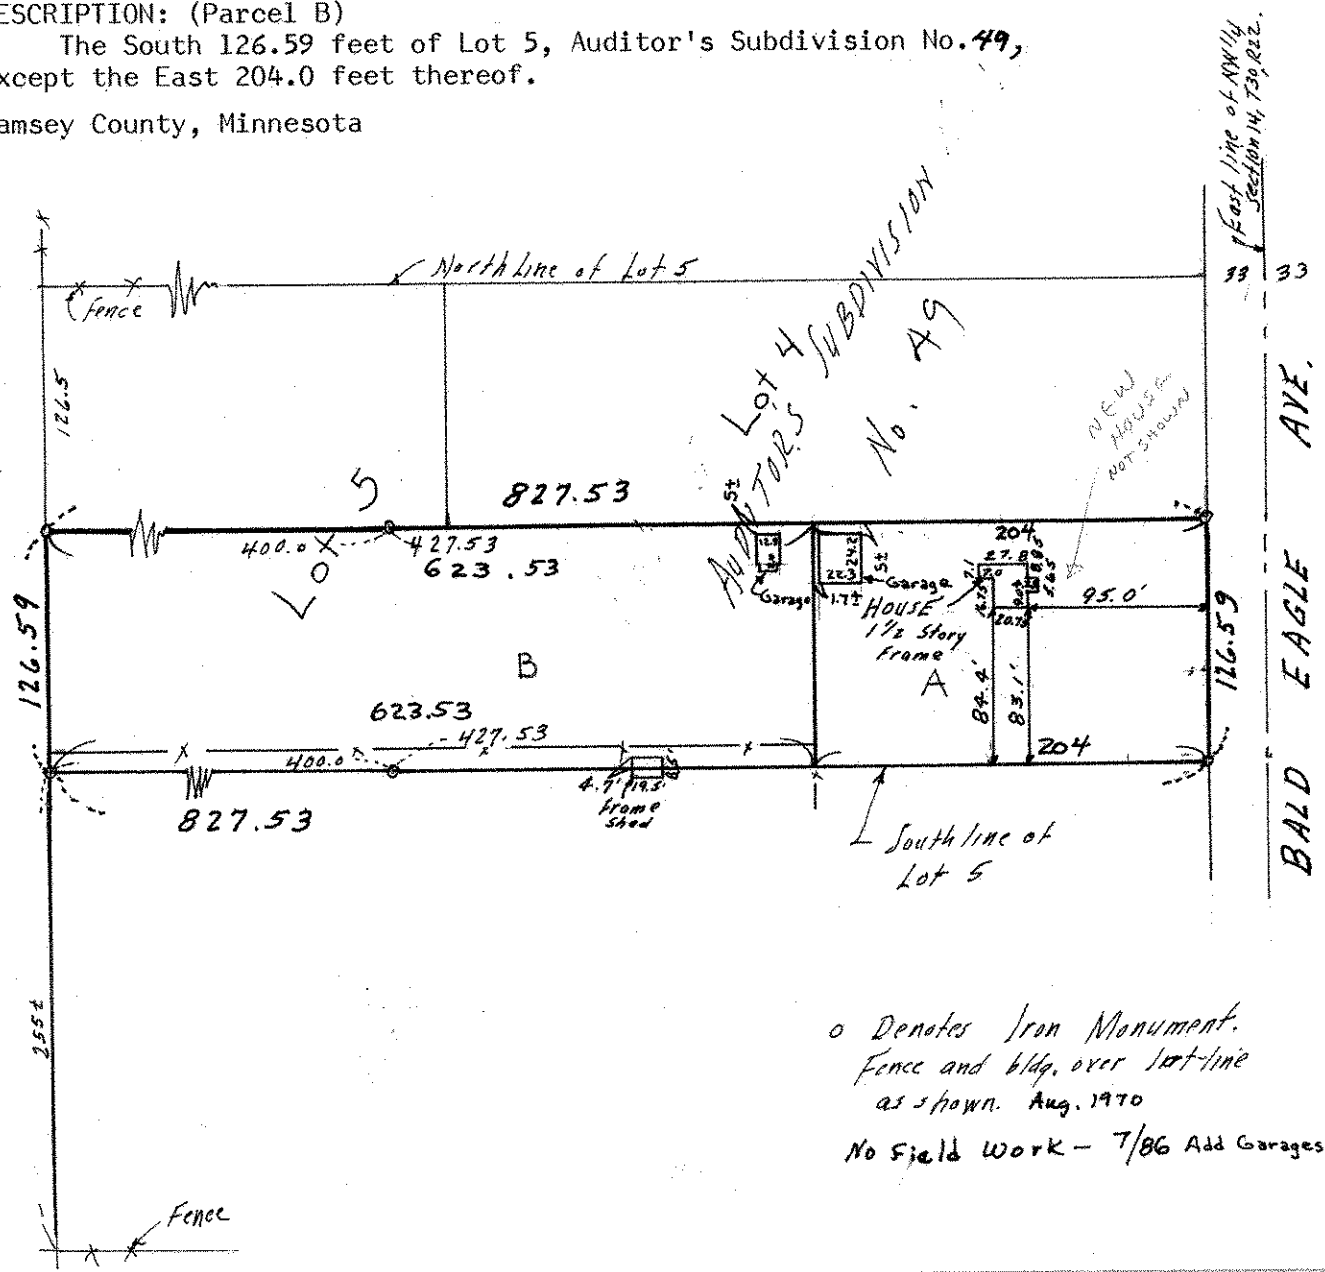

o Denotes Iron Monument.
Fence and bldg. over lot line
as shown. Aug. 1970
No field work - 7/86 Add Garages & Lot Split