

12

11-30-22

BENSON'S

BALD EAGLE LAKE PARK,

PART OF LOT 3 SECTION 2, T. 30, R. 22.


RAMSEY CO. MINN.

John B. Irvine, Surveyor.

June 14, 1920.

Scale, 50 ft. per inch.

BALD EAGLE LAKE

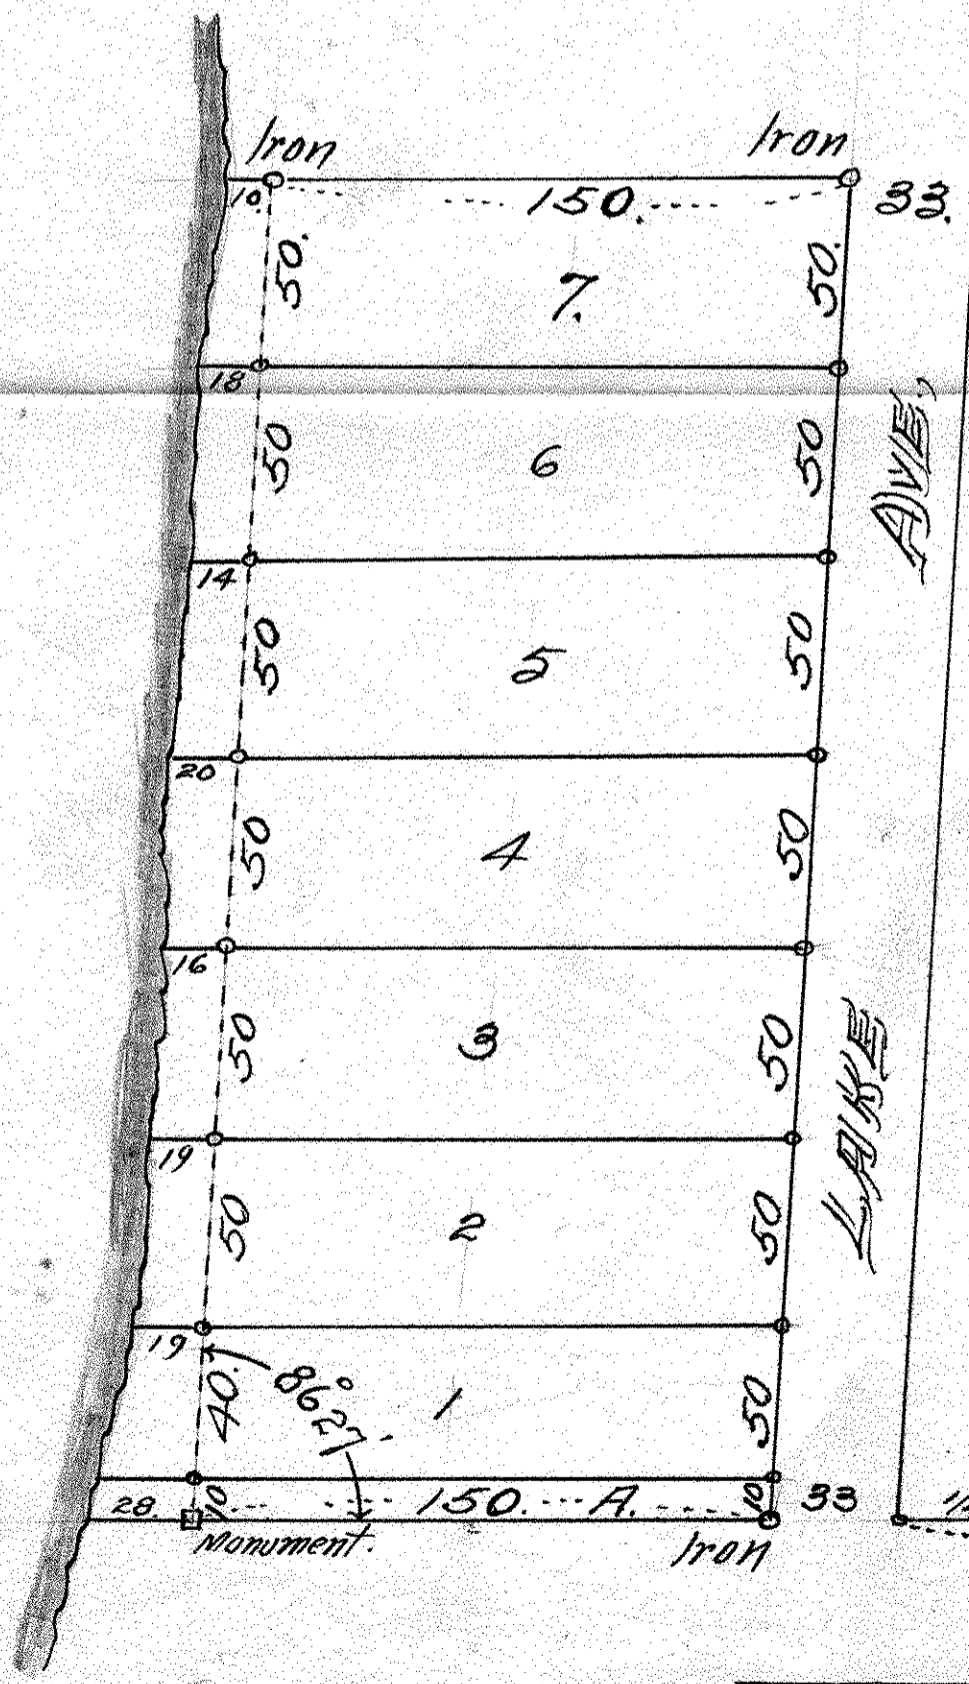

GOVT LOT 3

1/4 Sec line
 1167.6
 Mont.
 1/4 Cor.
 Between
 Secs 18-2.
 T. 30, R. 22