Certificate of Survey

FROM THE OFFICE OF

CHARLES O. GEORGI COMPANY

2215 West County Road B Saint Paul, Minnesota 55113

REGISTERED CIVIL ENGINEER AND LAND SURVEYOR

I Hereby Certify that this plat shows a survey made by me of the property described on this plat, and that the corners are correctly placed as shown, and that all locations have been correctly shown.

Surveyed For James A. Morton

Date October 1972

Scale 1" = 40

By Charles O. Georgi

REGISTERED LAND SURVEYOR

Description:

Lot 33, Block 12, Bacchus
White Bear Hills, Ramsey County,
Minnesota.
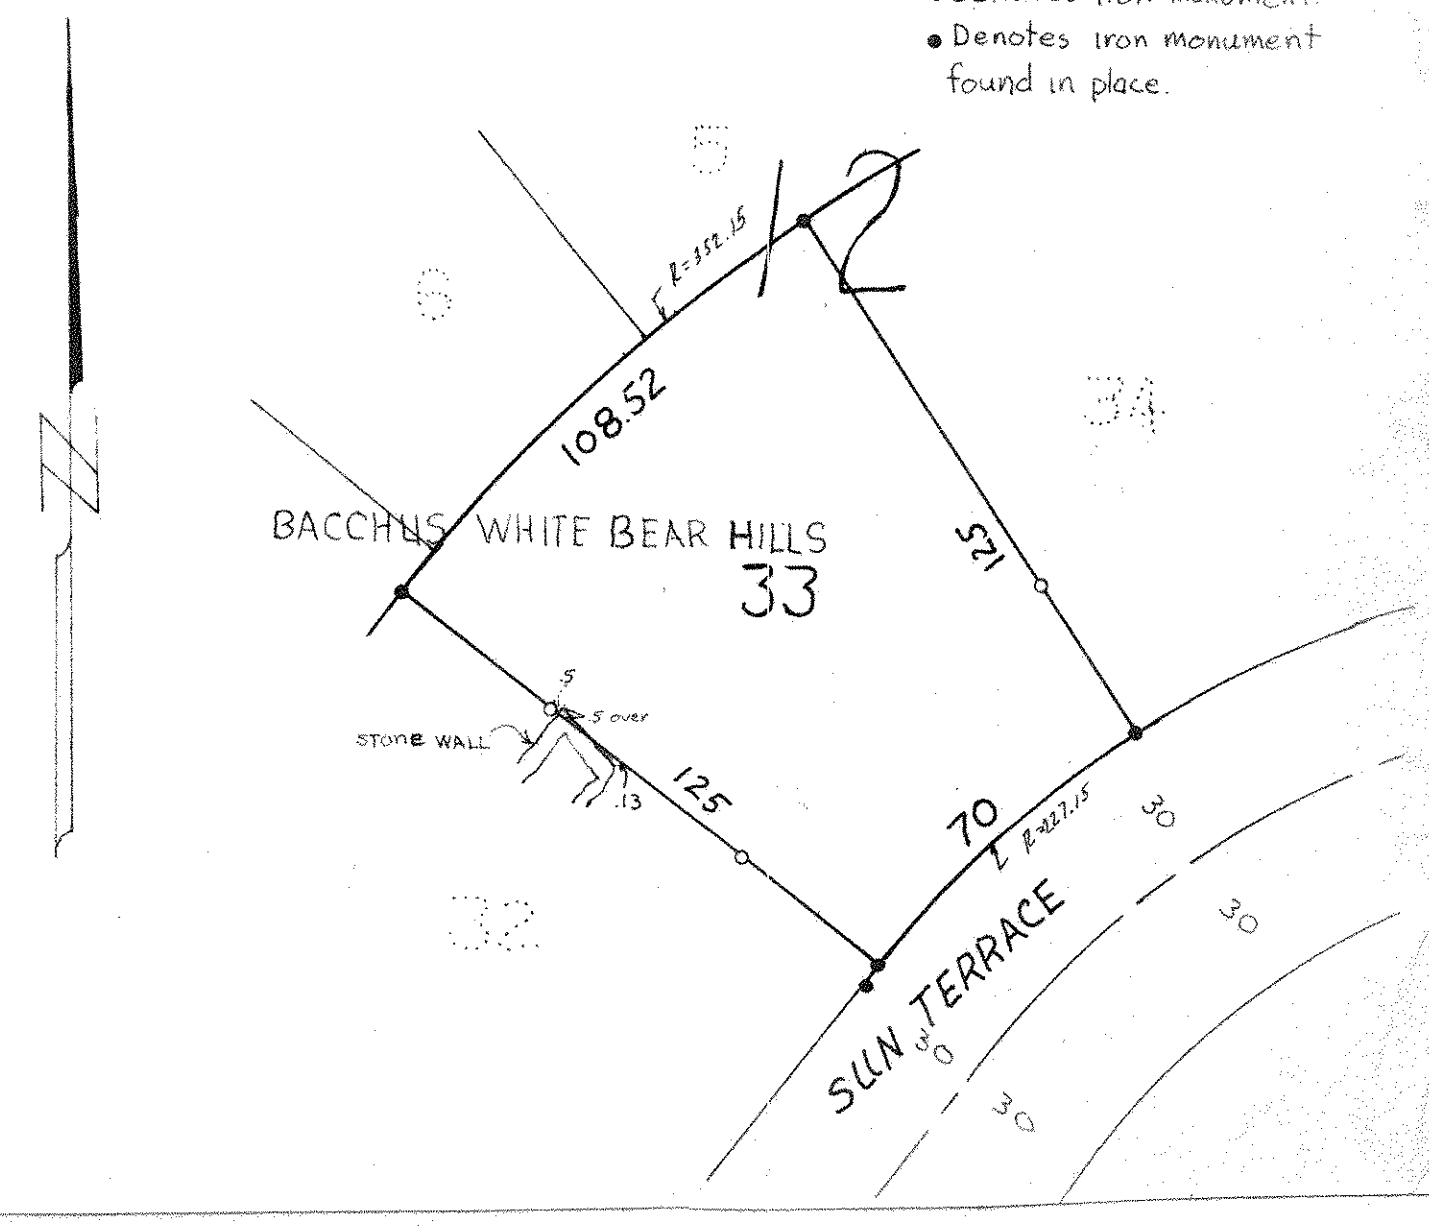
o Denotes iron Monument.
• Denotes iron monument found in place.