

FROM THE OFFICE OF

# CHARLES O. GEORGI COMPANY

2215 West County Road B

Saint Paul, Minnesota 55113

REGISTERED CIVIL ENGINEER AND LAND SURVEYOR

## Certificate of Survey

I Hereby Certify that this plat shows a survey made by me of the property described on this plat, and that the corners are correctly placed as shown, and that all locations have been correctly shown.


Surveyed For *George Franksen*  
Date *August 1975*  
Scale *1" = 40'*

By *Charles O. Georgi*  
REGISTERED LAND SURVEYOR

**Description:**

*Lots 5, Block 11,  
Bel-Air Park No. 2,  
Ramsey County,  
Minnesota*

MAYFAIR AVE.

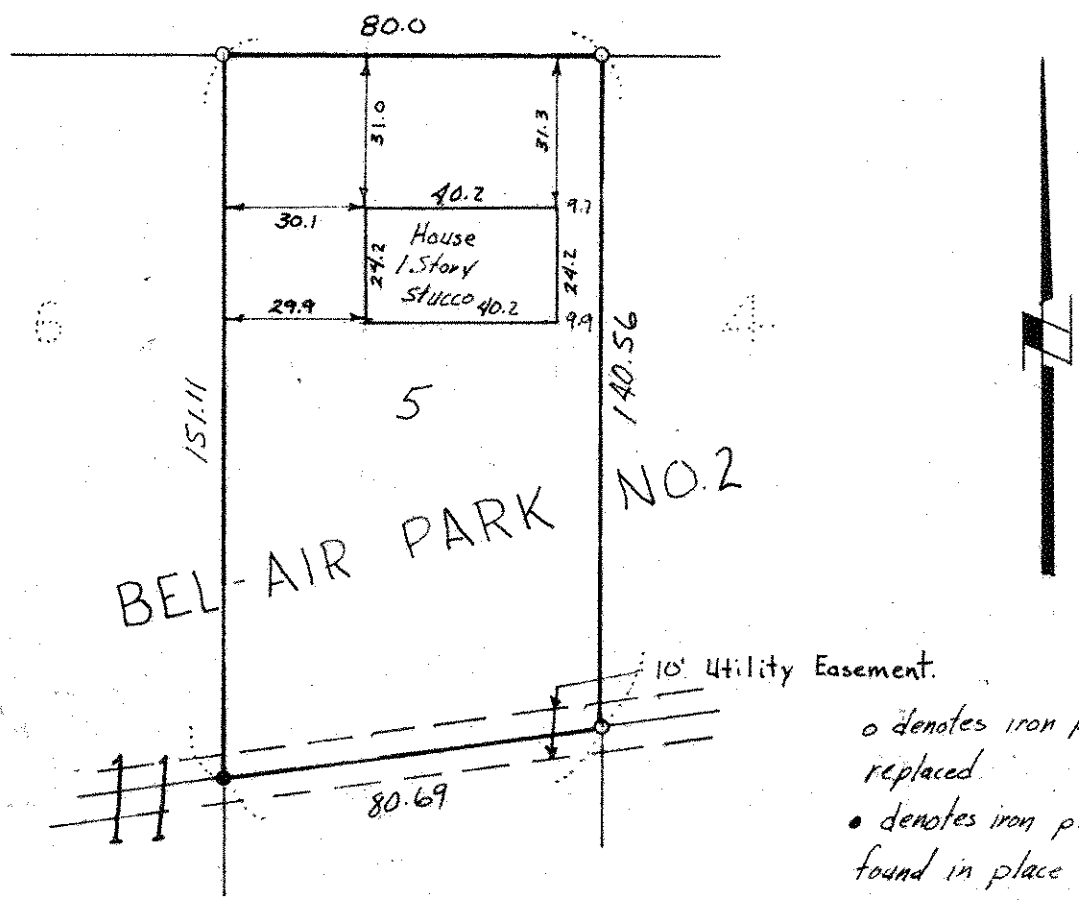

10' Utility Easement.

- o denotes iron pipe monument replaced.
- denotes iron pipe monument found in place