

FROM THE OFFICE OF

# CHARLES O. GEORGI COMPANY

2215 West County Road B

Saint Paul, Minnesota 55113

REGISTERED CIVIL ENGINEER AND LAND SURVEYOR

## Certificate of Survey

I Hereby Certify that this plat shows a survey made by me of the property described on this plat, and that the corners are correctly placed as shown, and that all locations have been correctly shown.


Surveyed For Bruggeman Corp  
Date April 1975  
Scale 1" = 40'

By James S. Georgi  
REGISTERED LAND SURVEYOR

**Description:**

Lot 3,  
Block 11,  
Bel Air Park No 2  
Ramsey county,  
Minnesota

MAYFAIR AVE.

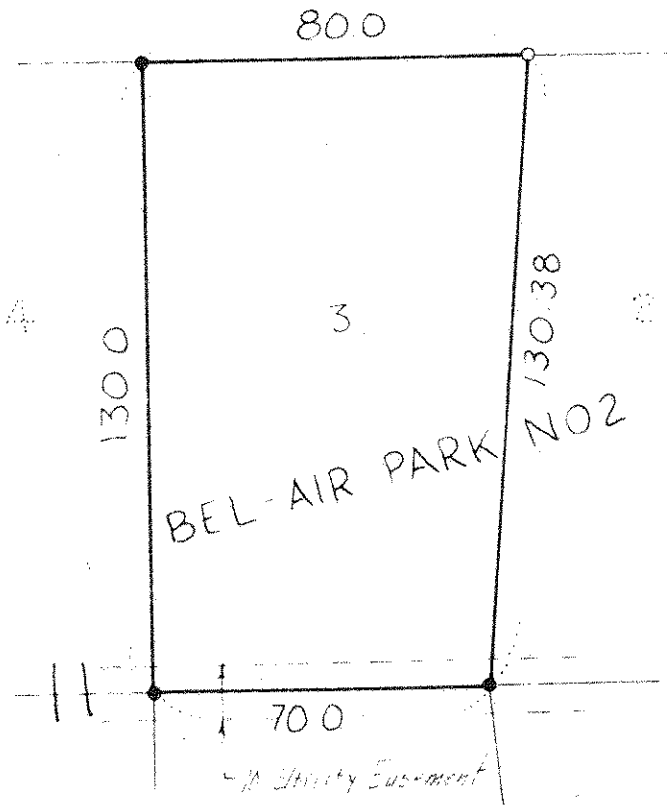

o denotes iron pipe monument  
• denotes iron pipe monument found in place