FILE - SEC-24-30-22

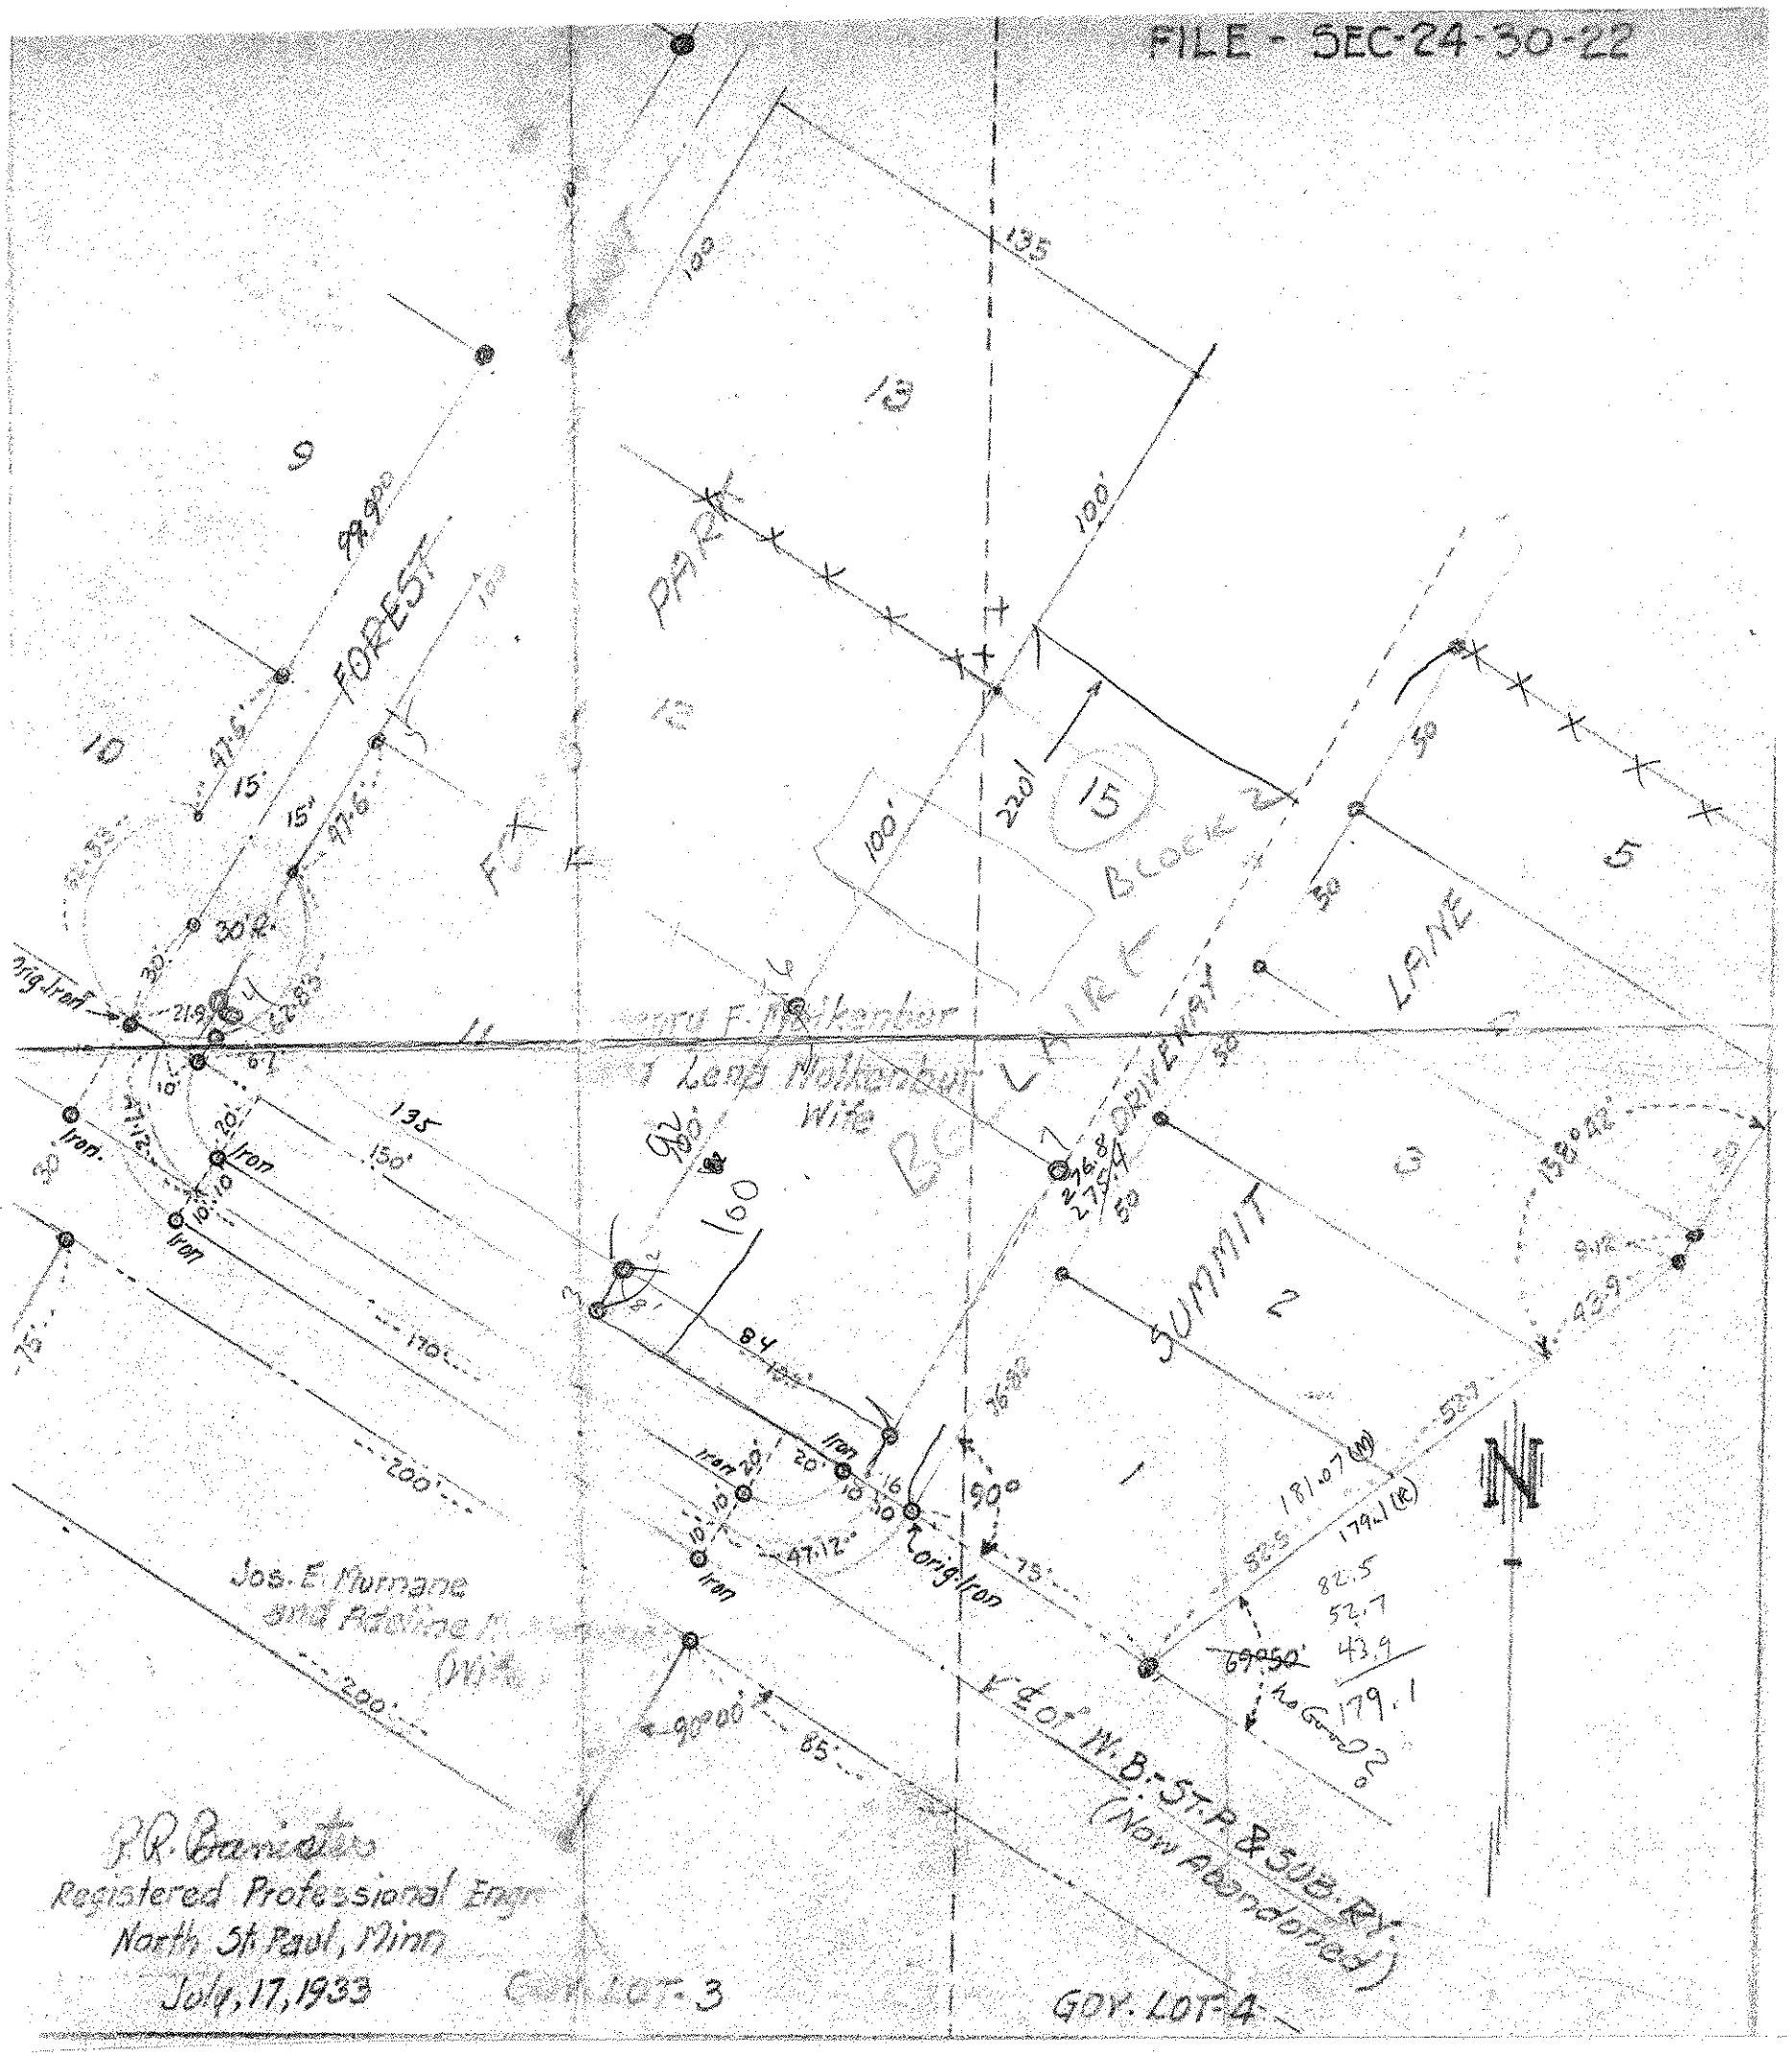

P. R. Granieter
Registered Professional Engr
North St Paul, Minn
July, 17, 1933