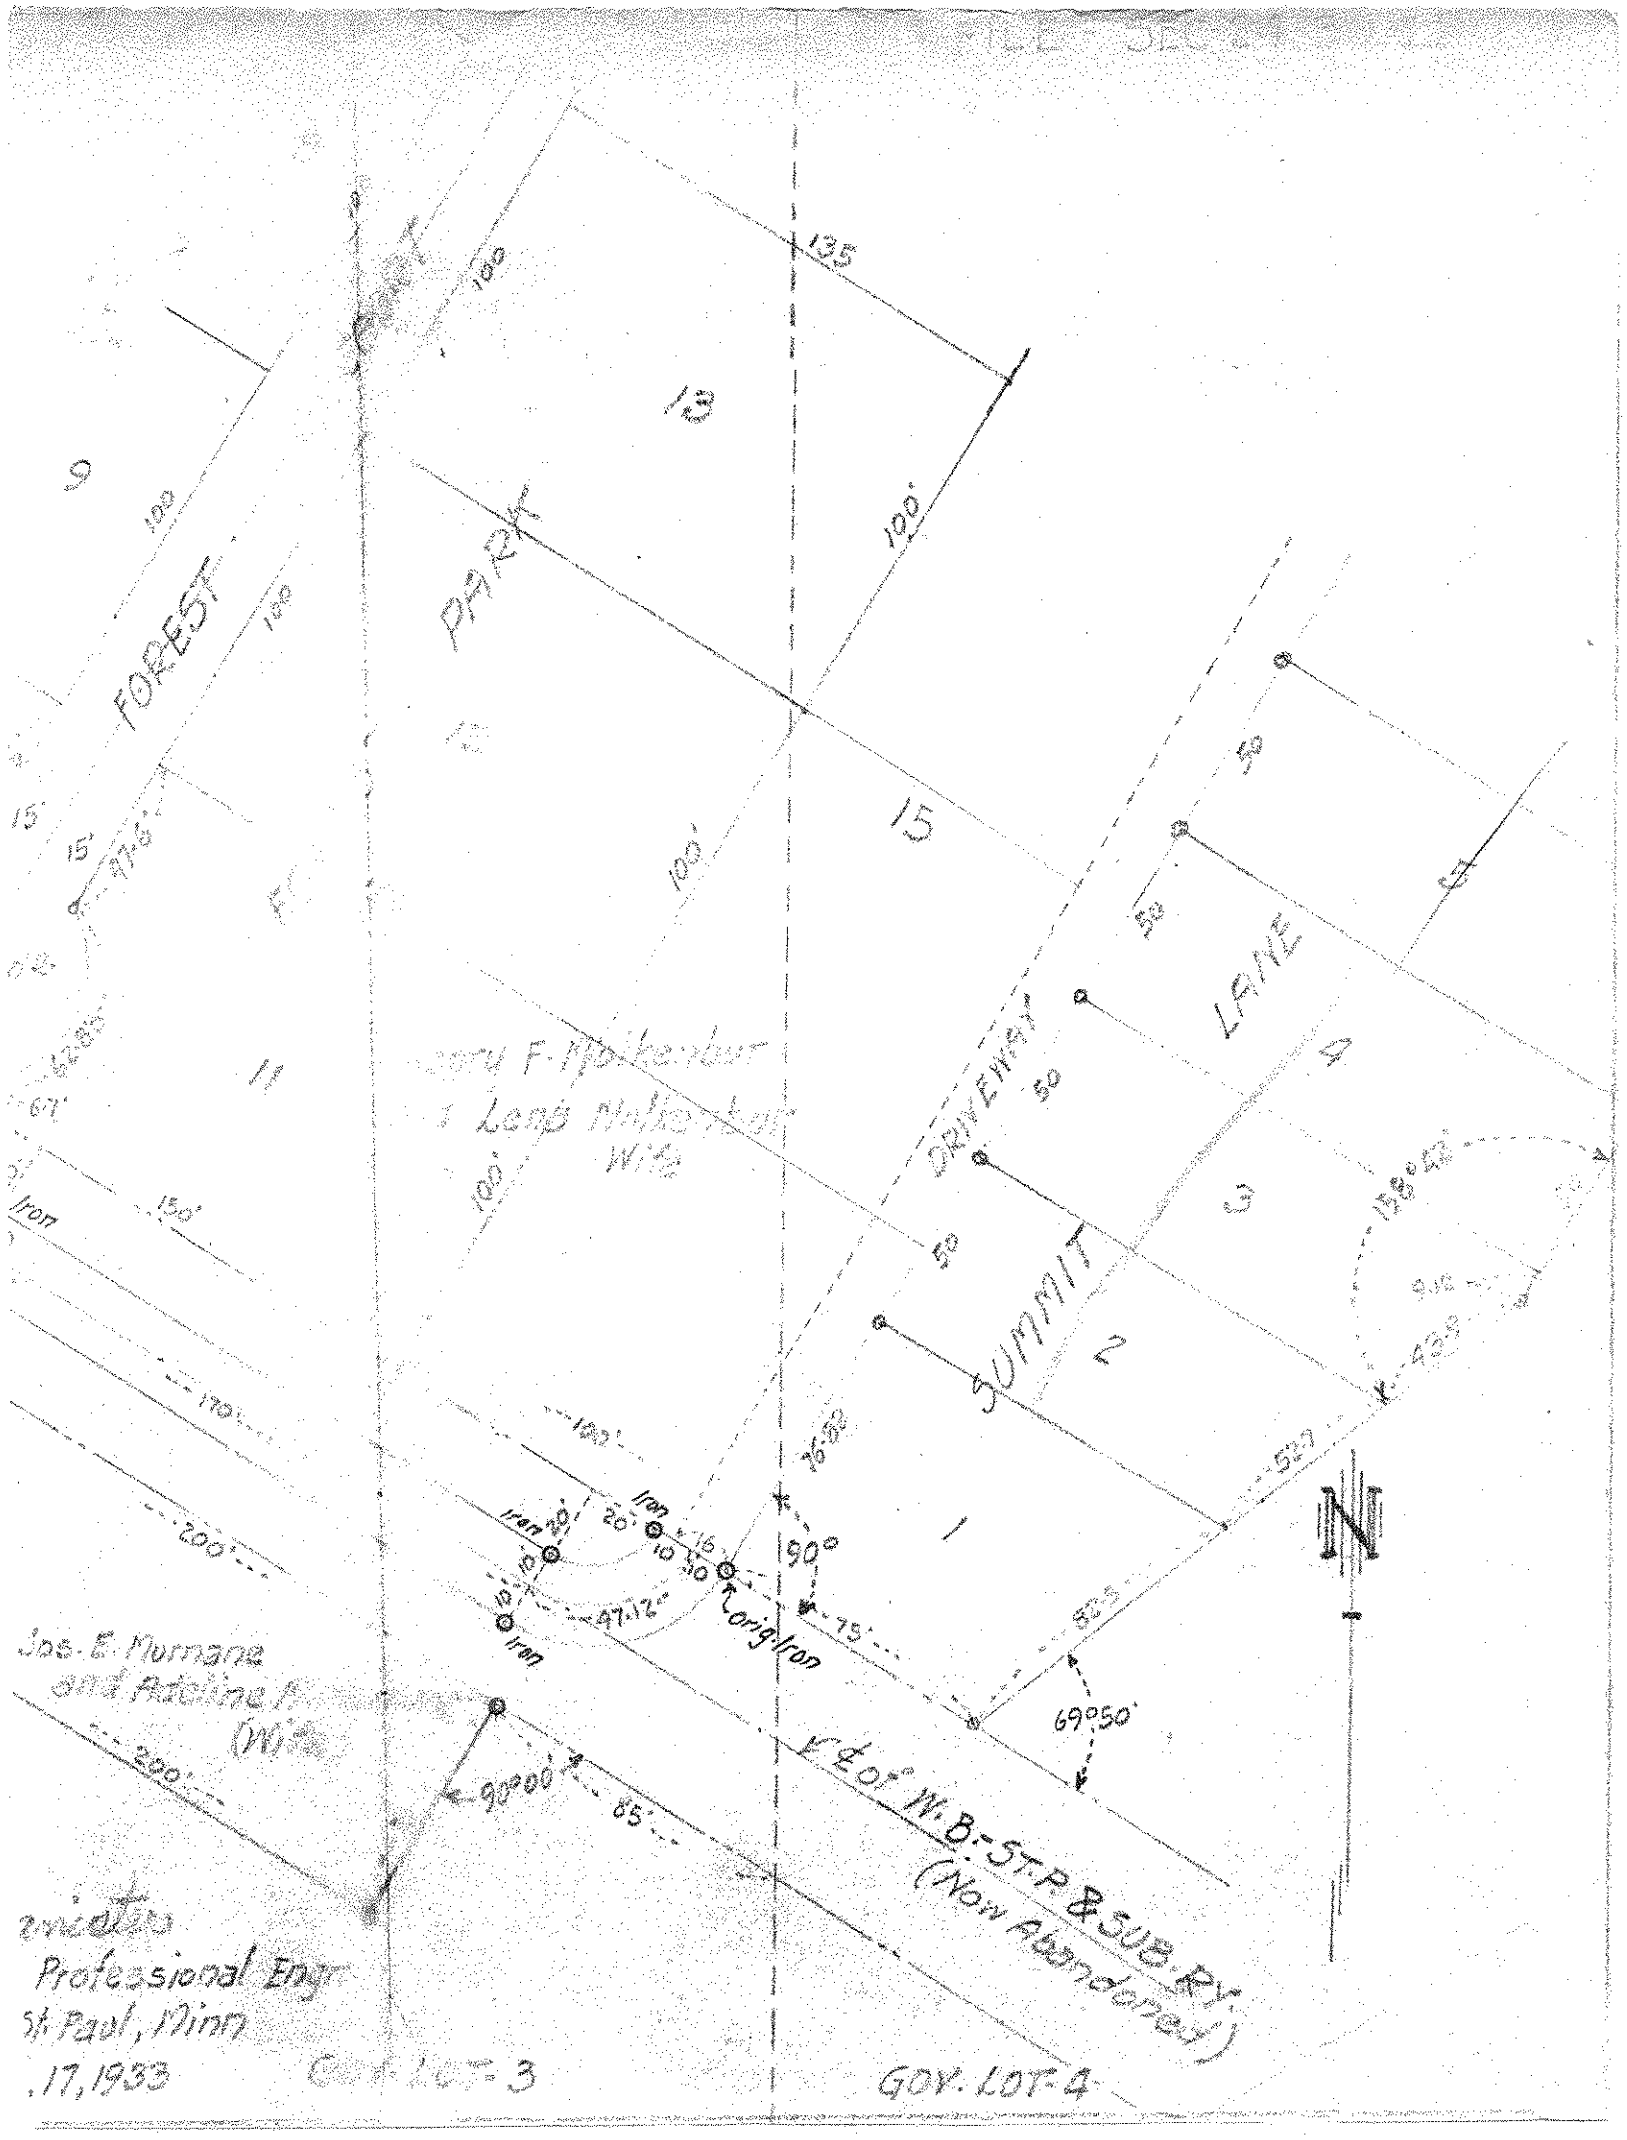

FOREST
PARK
SUMMIT
LANE
DRIVEWAY
135
100
100'
50
15
13
9
11
4
3
2
1
Iron
Orig. Iron
90°
75'
69°50'
47.12'
90°00'
85'
158°42'
52.7
43.8
N
℄ of W.B.-ST.P. & SUB. RY.
(Now Abandoned)
Jos. E. Murnane
and Adeline
(Wife)
Professional Engr.
St. Paul, Minn.
.17, 1933
GOV. LOT 3
GOV. LOT 4