SW 14 30 22

FROM THE OFFICE OF

CHARLES O. GEORGI COMPANY

2215 West County Road B Saint Paul, Minnesota 55113

REGISTERED CIVIL ENGINEER AND LAND SURVEYOR

Certificate of Survey

I Hereby Certify that this plat shows a survey made by me of the property described on this plat, and that the corners are correctly placed as shown, and that all locations have been correctly shown.

12/29/70 added House and Garage location

Surveyed For Erland Maki

Date November, 1970

Scale 1"=60'

By Charles O. Georgi
REGISTERED LAND SURVEYOR

Description:
The North 125 feet of lot 4, Block 1, W.F. Krech's Addition, Ramsey County, Minnesota.

Description:
All of lot 4, Block 1, W.F. Krech's Addition, except the North 125 feet thereof, Ramsey County, Minnesota.

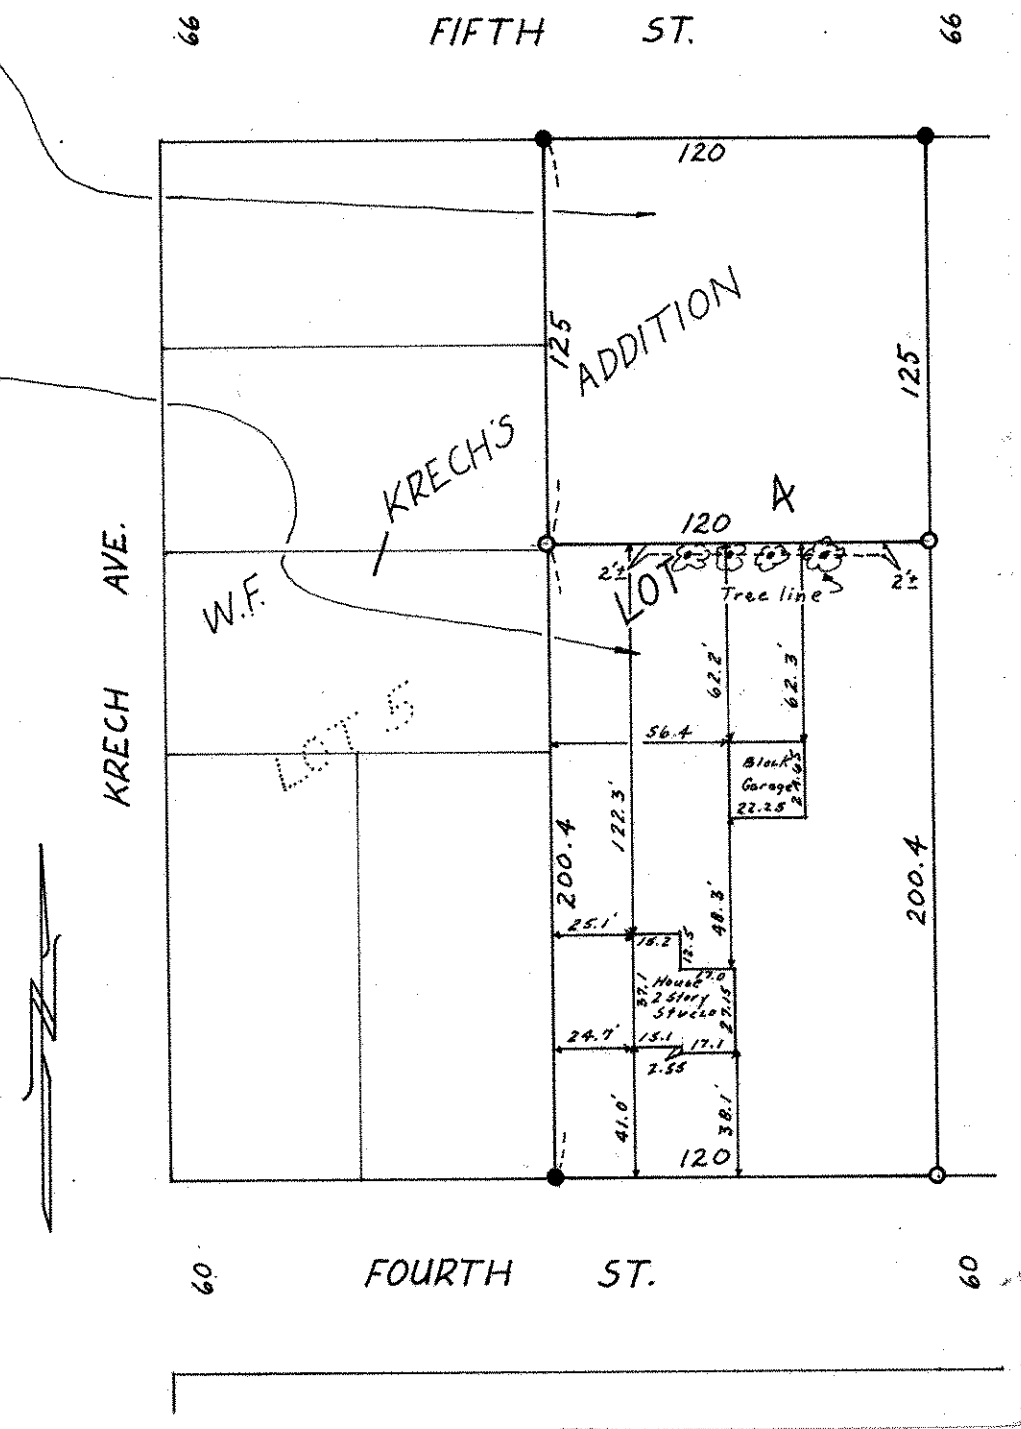

○ Denotes Iron Pipe Monument

● Denotes Iron Pipe Monument found in place