FROM THE OFFICE OF NE 25 30 22

CHARLES O. GEORGI COMPANY

2215 West County Road B Saint Paul 13, Minnesota

REGISTERED CIVIL ENGINEER AND LAND SURVEYOR

Certificate of Survey

I Hereby Certify that this plat shows a survey made by me of the property described on this plat, and that the corners are correctly placed as shown, and that all locations have been correctly shown.

Surveyed For Mailand Const. Co.

Date Aug. 4, 1965

Scale 1" = 100'

By Charles O. Georgi
REGISTERED LAND SURVEYOR

Description:

MIDDLE APT. SITE:
The North 123.33 feet of the South 246.66 feet of the North 1/2 of the NW1/4 of the NE1/4 of Section 25, T30N, R22W, Ramsey County, Minn. except the East 880 feet thereof.
Subject to Bellaire Ave.

NORTH APT. SITE:
The North 123.34 feet of the South 370 feet of the North 1/2 of the NW1/4 of the NE1/4 of Section 25, T30N, R22W, Ramsey County, Minn. except the East 880 feet thereof.
Subject to Bellaire Ave.

SOUTH APT. SITE:
The South 123.33 feet of the North 1/2 of the NW1/4 of the NE1/4 of Section 25, T30N, R22W, Ramsey County, Minn. except the East 880 feet thereof.
Subject to Bellaire Ave.

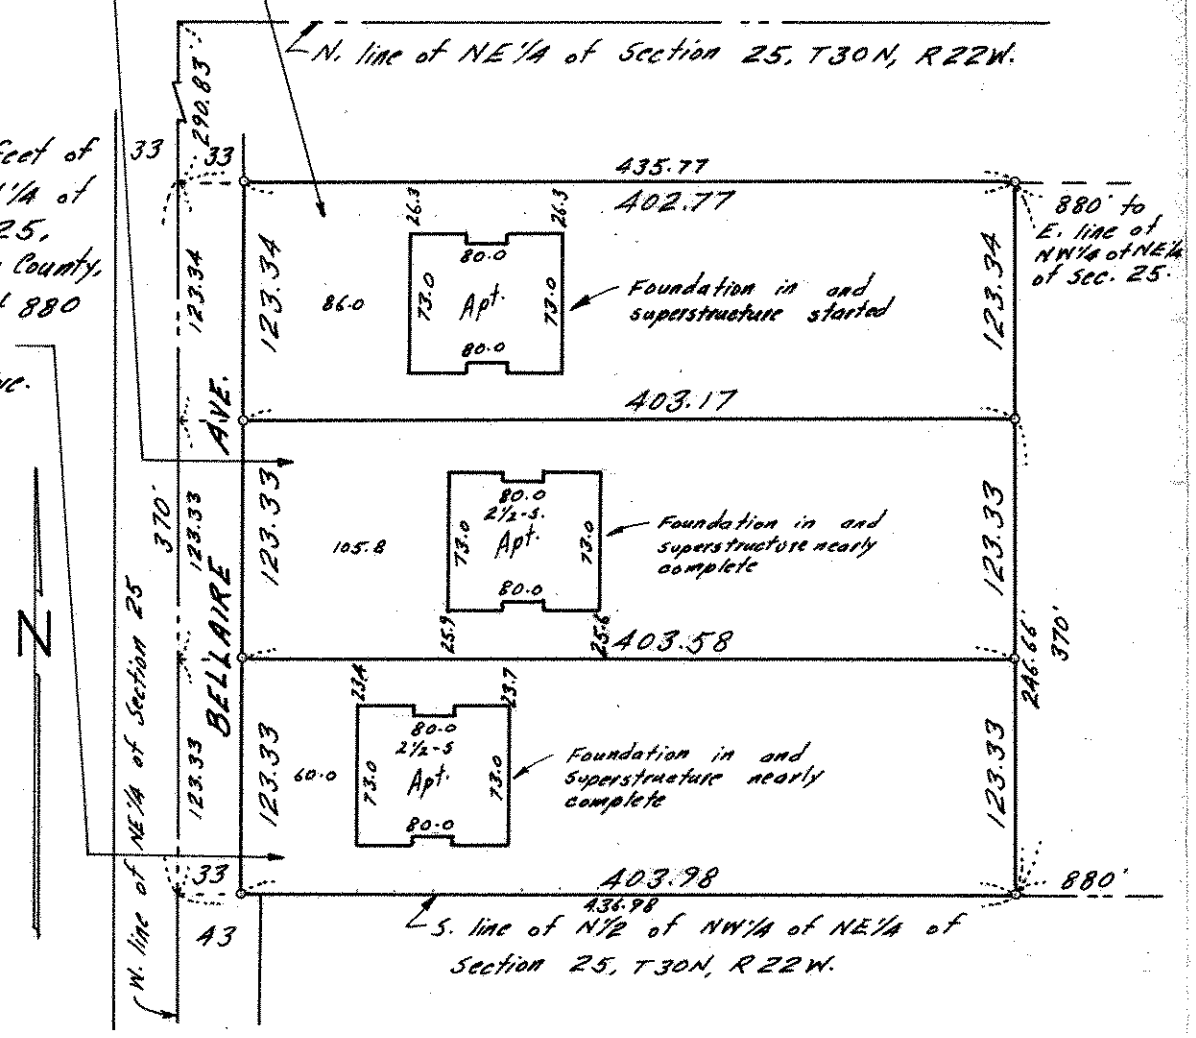

○ Denotes Iron Monument