NE c 28 22

FROM THE OFFICE OF

CHARLES O. GEORGI COMPANY

2215 West County Road B — Saint Paul, Minnesota 55113

REGISTERED CIVIL ENGINEER AND LAND SURVEYOR

Certificate of Survey

I Hereby Certify that this plat shows a building location survey made by me on the property described on this plat, and that all locations, have been correctly shown.

Minnesota Mutual Life

Date March 17, 1971

Scale 1" = 30'

By Charles O. Georgi
REGISTERED LAND SURVEYOR

Description:
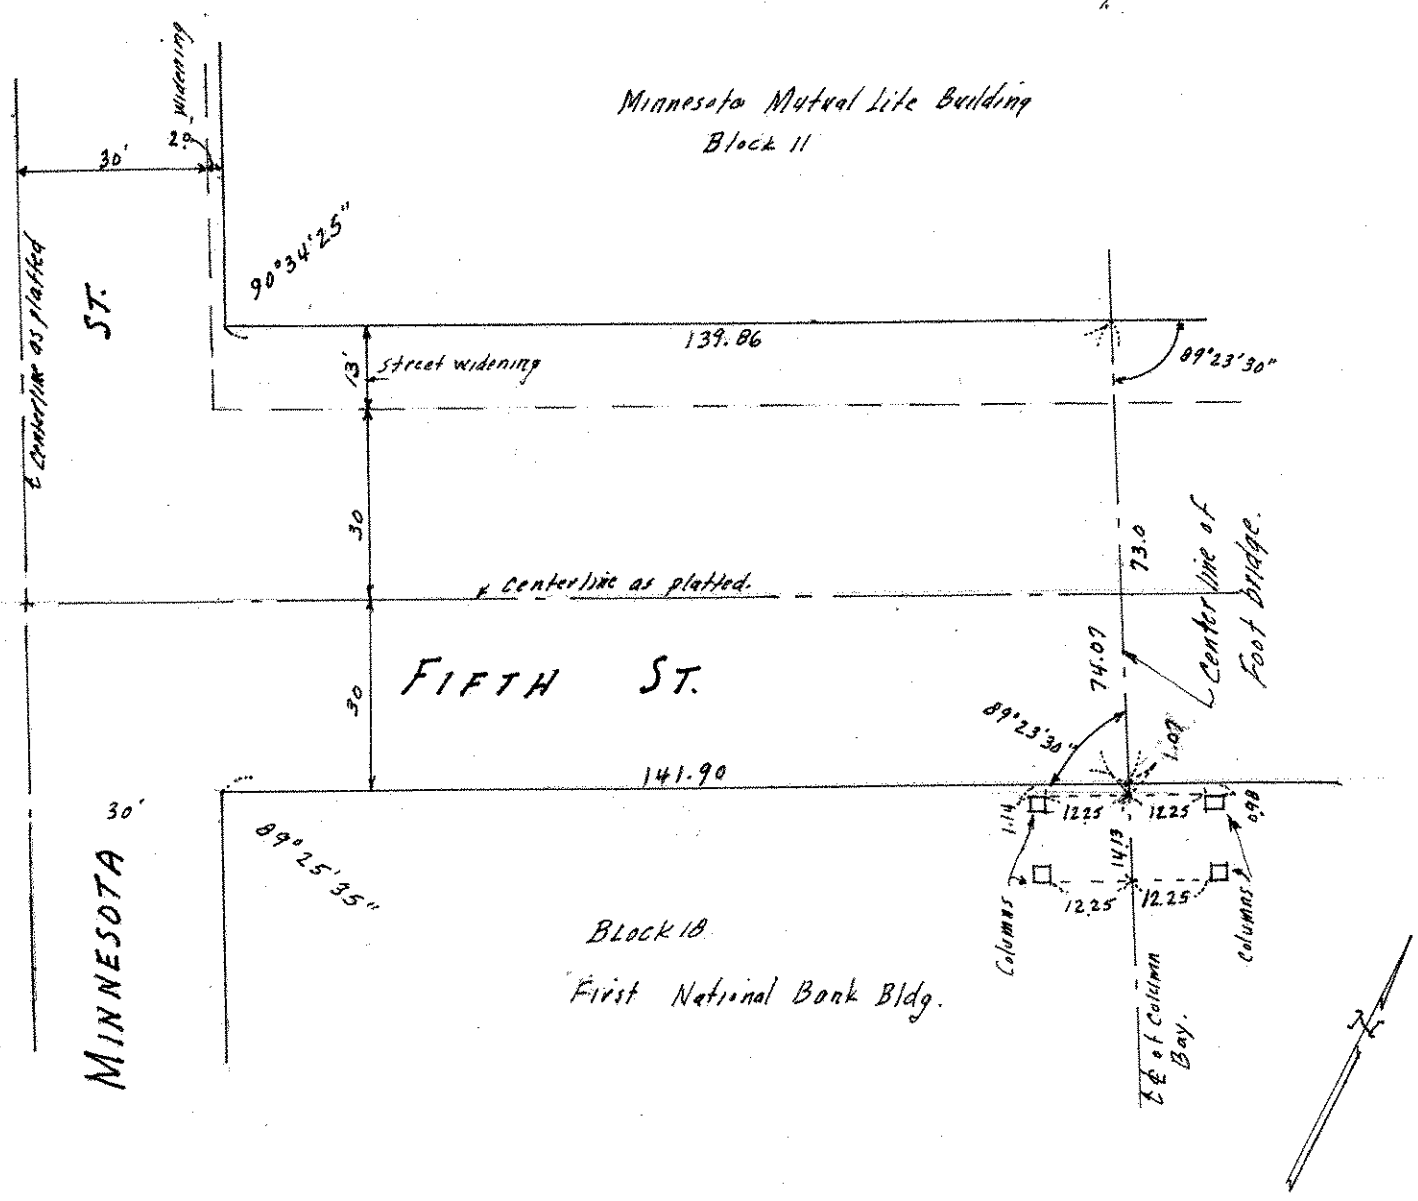
FOOT BRIDGE LOCATION ACROSS FIFTH ST.
from MINNESOTA MUTUAL LIFE BLDG to FIRST NATIONAL BANK BLDG.
per. Wold Assoc., Architect, sketch on ℄ of column Bay