

**Certificate  
of Survey**

From the office of  
**GEORGI-SCHMIDT & ASSOC. INC.**  
3092 No. Lexington Ave., Roseville, Mn. 55113  
LAND SURVEYING  
483-4408

I Hereby Certify that this plat shows a survey made by me of the property described on this plat, and that the corners are correctly placed as shown, and that all locations have been correctly shown.

Job Number: 554

Surveyed For Eldon Morrison


Date 12/20/79

Scale 1" = 50'

By Donald W Schmidt  
REGISTERED LAND SURVEYOR

**Description:**

*Lot 5, Block 1  
South Heights Addition,  
Ramsey County, Minnesota.*

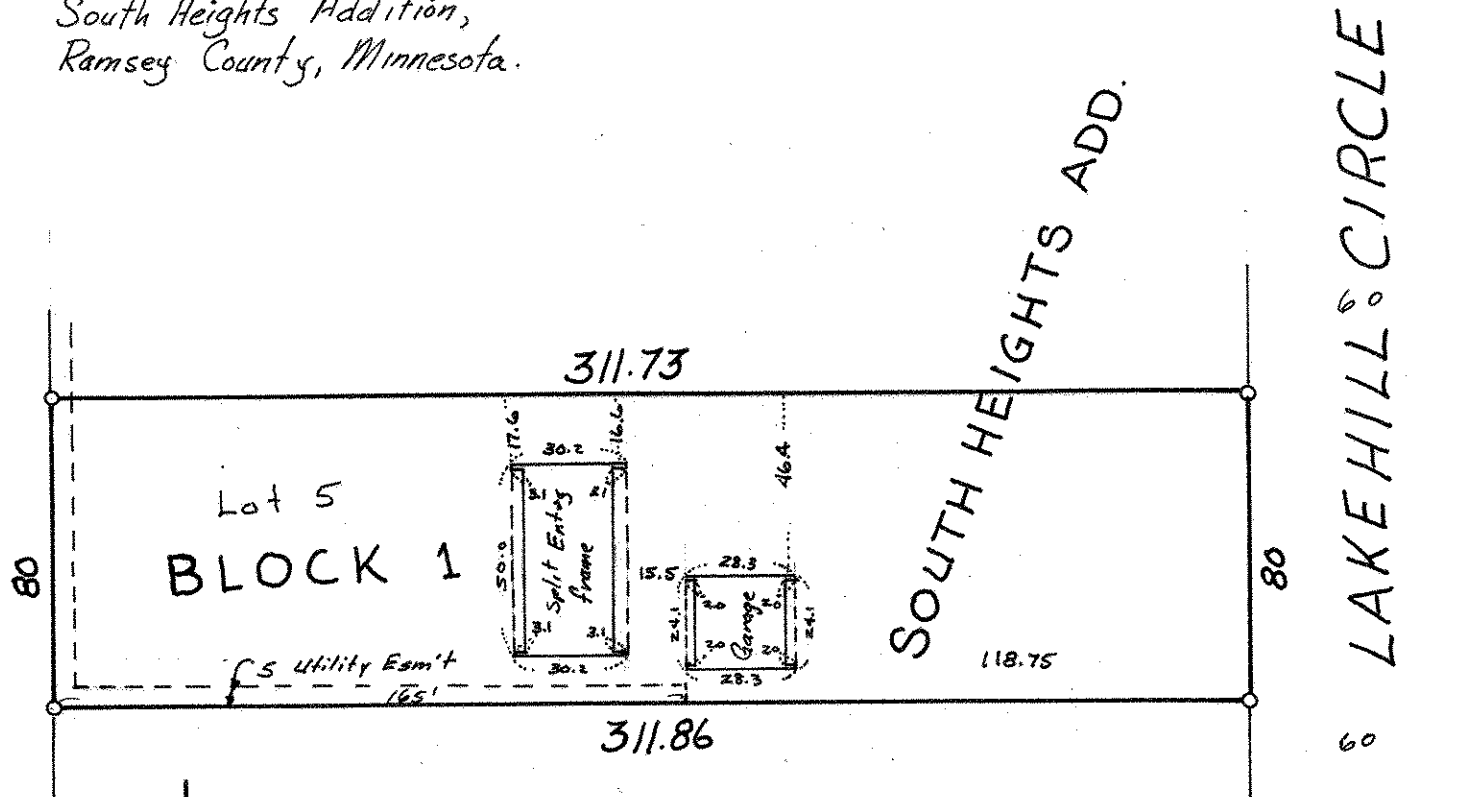

o Denotes iron pipe monument