NW 35 30 22

Certificate of Survey

FROM THE OFFICE OF

CHARLES O. GEORGI COMPANY

2215 West County Road B — Saint Paul, Minnesota 55113

REGISTERED CIVIL ENGINEER AND LAND SURVEYOR

I Hereby Certify that this plat shows a survey made by me of the property described on this plat, and that the corners are correctly placed as shown, and that all locations have been correctly shown. Corners placed as shown 5/68.

Surveyed For Walter Muhonen, Robert G. Flynn - Attorney

Date April 16, 1971

Scale 1" = 100'

By Charles O. Georgi
REGISTERED LAND SURVEYOR

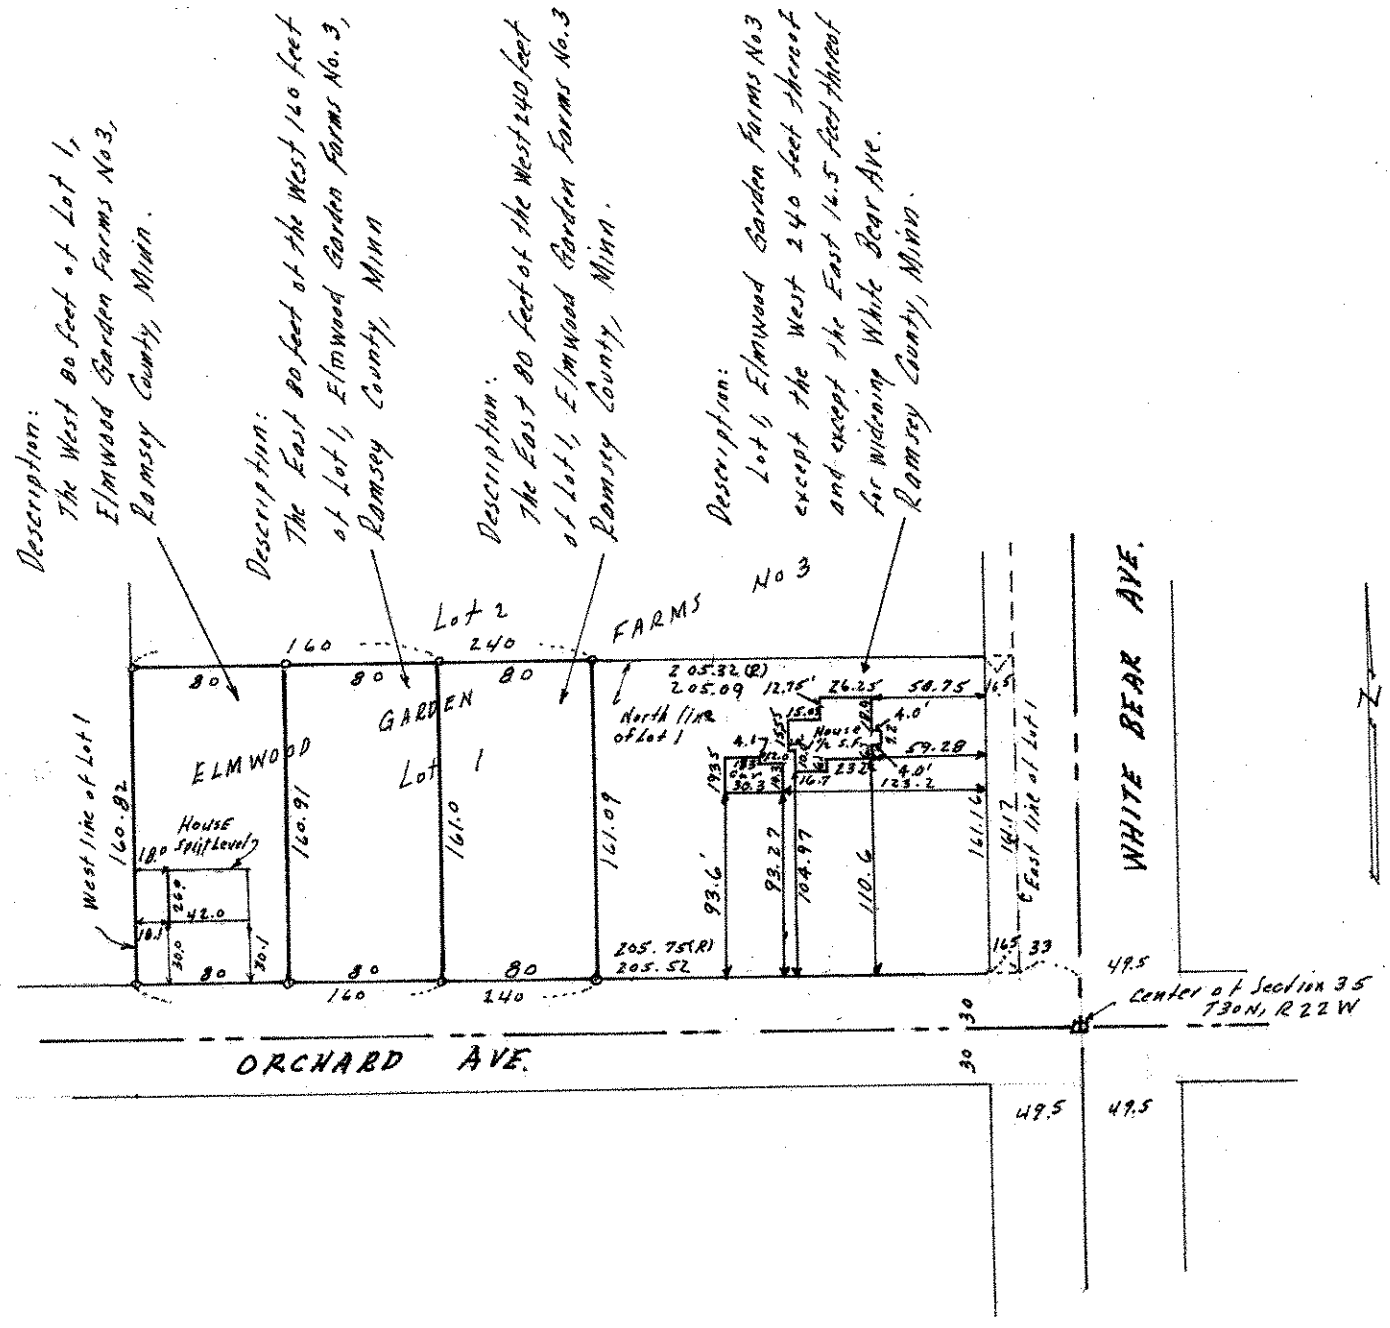

o Denotes Iron Monument
R- Denotes record plat distance