

# Certificate of Survey

From the office of  
**GEORGI-SCHMIDT & ASSOC. INC.**  
 3092 No. Lexington Ave., Roseville, Mn. 55113  
 LAND SURVEYING  
 483-4408

I Hereby Certify that this plat shows a survey made by me of the property described on this plat, and that the corners are correctly placed as shown, and that all locations have been correctly shown.

Job Number: 10

Surveyed For Doris Mikeworth


Date July 17 1979

Scale 1" = 40'

By Donald W. Schmidt  
 REGISTERED LAND SURVEYOR

**Description:**

Lot 4,  
 Block 4,  
 Mikeworth Addition,  
 Ramsey County, Minnesota.

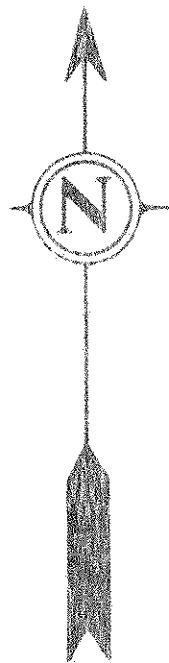

○ Denotes Iron Pipe Monument.  
 Easement as per plat only.  
 ● Denotes Iron Monument  
 found.

