NE 10 30 22

Certificate of Survey

From the office of

GEORGI- SCHMIDT & ASSOC. INC.

3092 No. Lexington Ave., Roseville, Mn. 55113

LAND SURVEYING

483-4408

I Hereby Certify that this plat shows a survey made by me of the property described on this plat, and that the corners are correctly placed as shown, and that all locations have been correctly shown.

Job Number: 10

Surveyed For Doris Mikeworth

Date July 17 1979

Scale 1" = 40'

By Donald W. Schmidt

REGISTERED LAND SURVEYOR

Description:

Lot 2,
Block 3,
Mikeworth Addition,
Ramsey County, Minnesota.

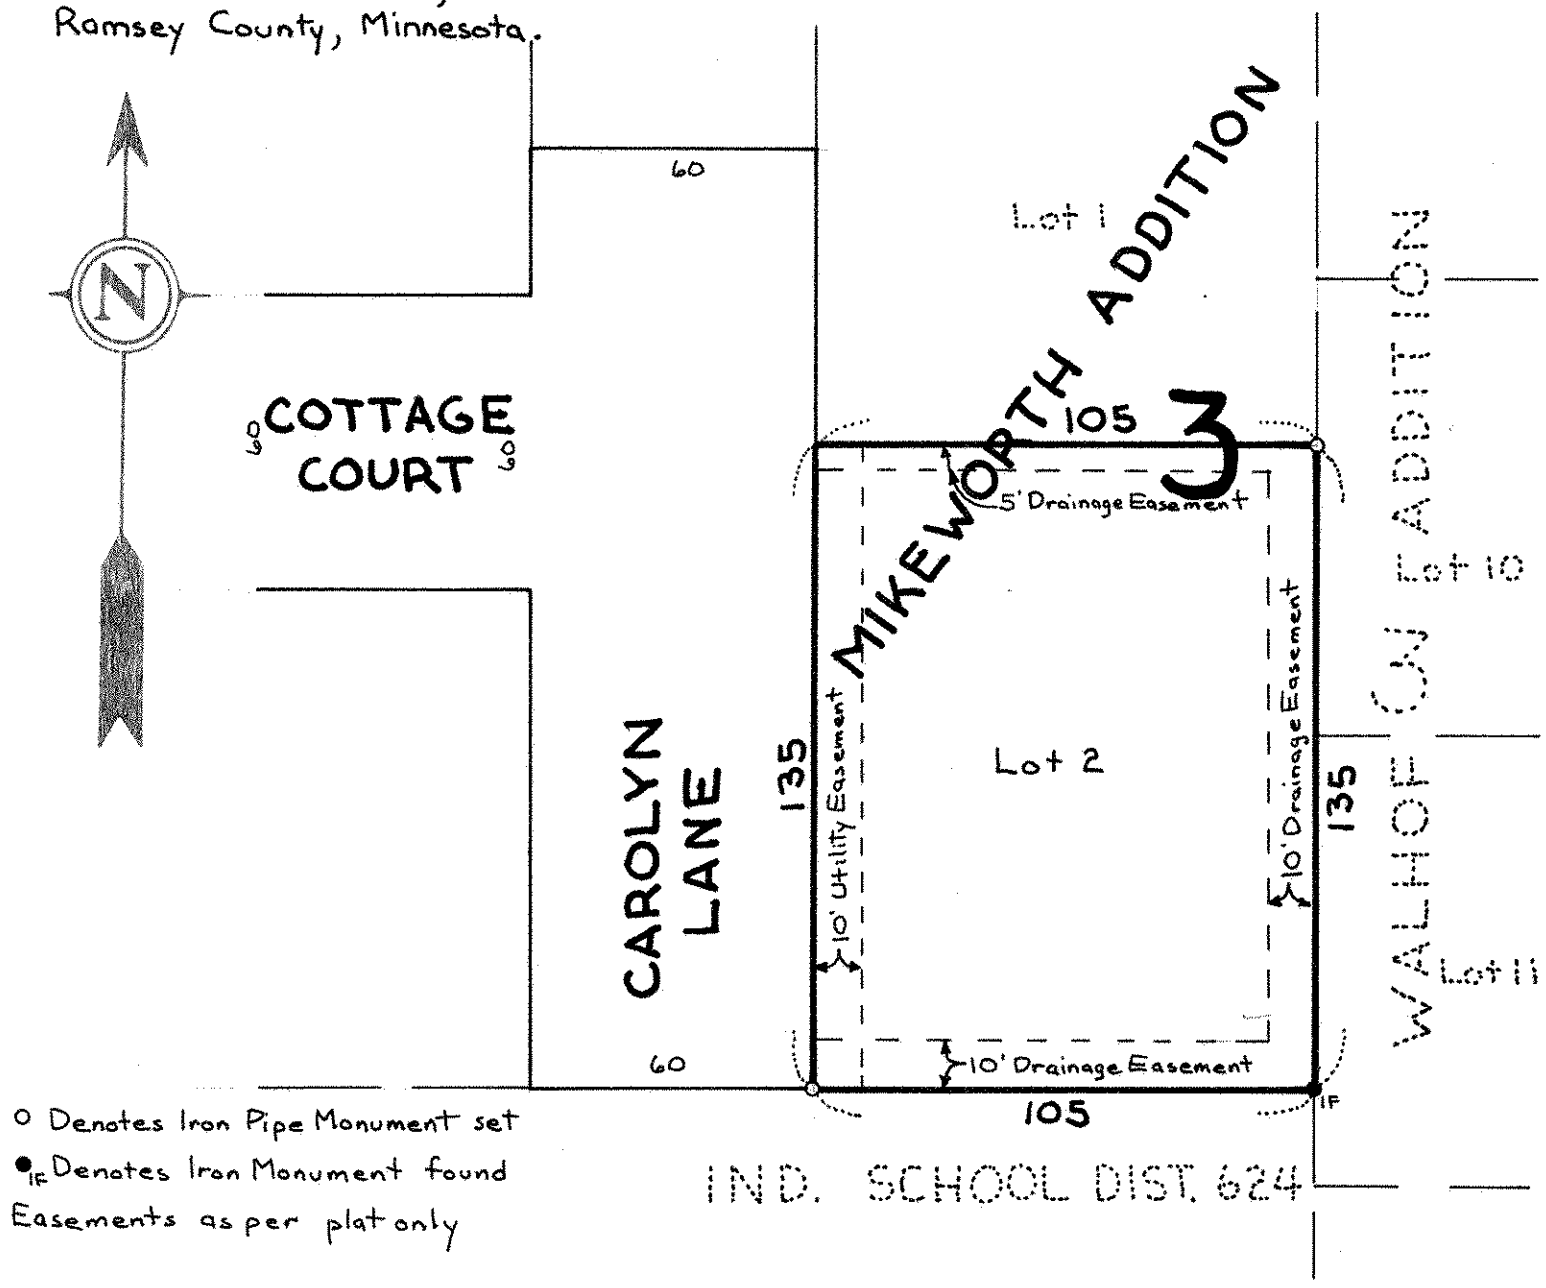

o Denotes Iron Pipe Monument set

● IF Denotes Iron Monument found

Easements as per plat only