

**Certificate  
of Survey**

From the office of  
**GEORGI-SCHMIDT & ASSOC. INC.**  
3092 No. Lexington Ave., Roseville, Mn. 55113  
LAND SURVEYING  
483-4408

I Hereby Certify that this plat shows a survey made by me of the property described on this plat, and that the corners are correctly placed as shown, and that all locations have been correctly shown.

Job Number: 10

Surveyed For Doris Mikeworth



Date July 17 1979

Scale 1" = 40'

By *Donald W. Schmidt*  
REGISTERED LAND SURVEYOR

**Description:**

Lot 1,  
Block 3,  
Mikeworth Addition,  
Ramsey County, Minnesota.

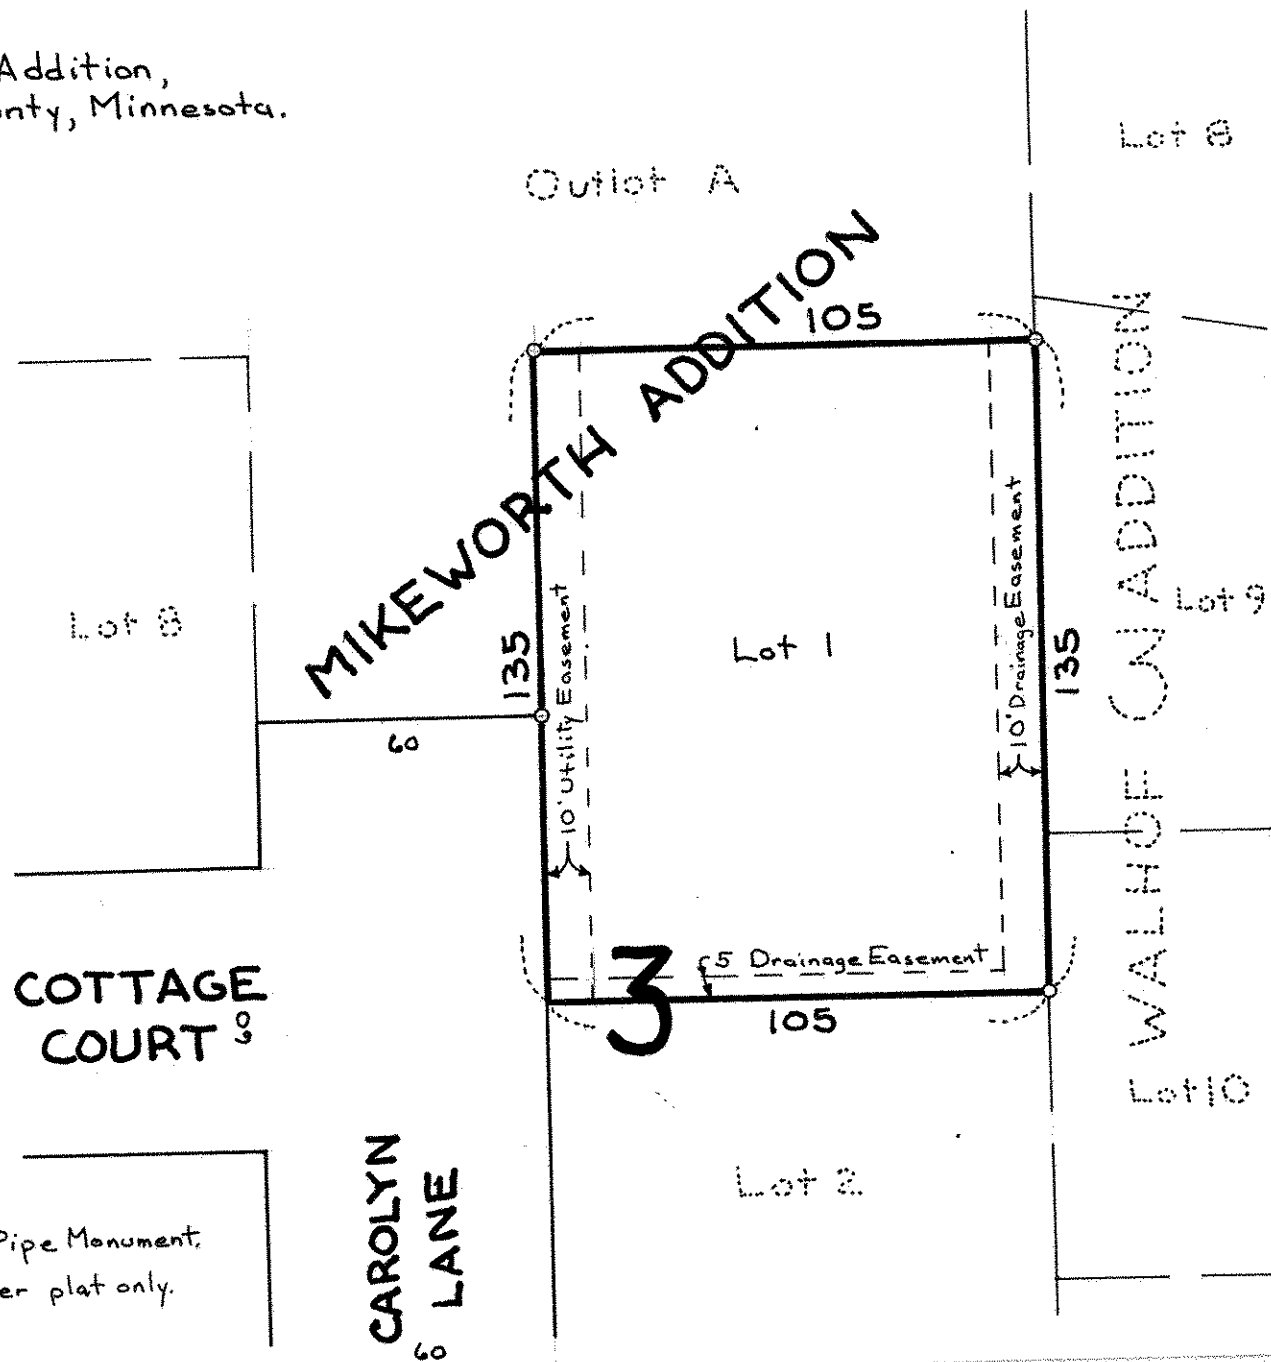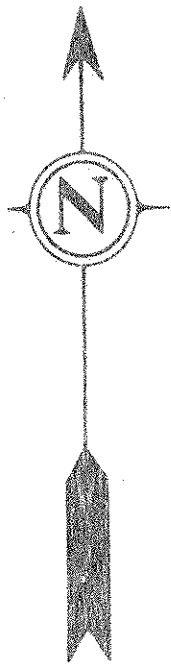

○ Denotes Iron Pipe Monument.  
Easements as per plat only.