

Certificate of Survey

From the office of
GEORGI-SCHMIDT & ASSOC. INC.
 3092 No. Lexington Ave., Roseville, Mn. 55113
 LAND SURVEYING
 483-4408

I Hereby Certify that this plat shows a survey made by me of the property described on this plat, and that the corners are correctly placed as shown, and that all locations have been correctly shown.

Job Number: 10

Surveyed For Doris Mikeworth


Date July 16, 1979

Scale 1"=40'


By Ronald W. Schmidt
 REGISTERED LAND SURVEYOR

Description:

Lot 6,
 Block 2,
 Mikeworth Addition,
 Ramsey County, Minnesota.

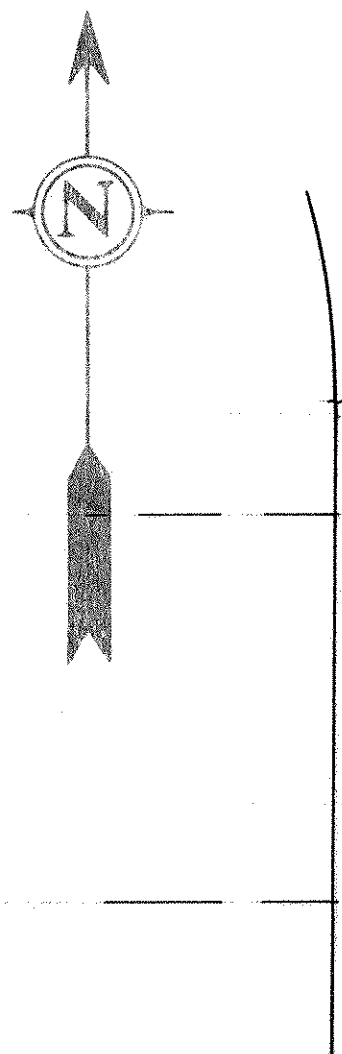

60
 COTTAGE AVENUE 60
 60

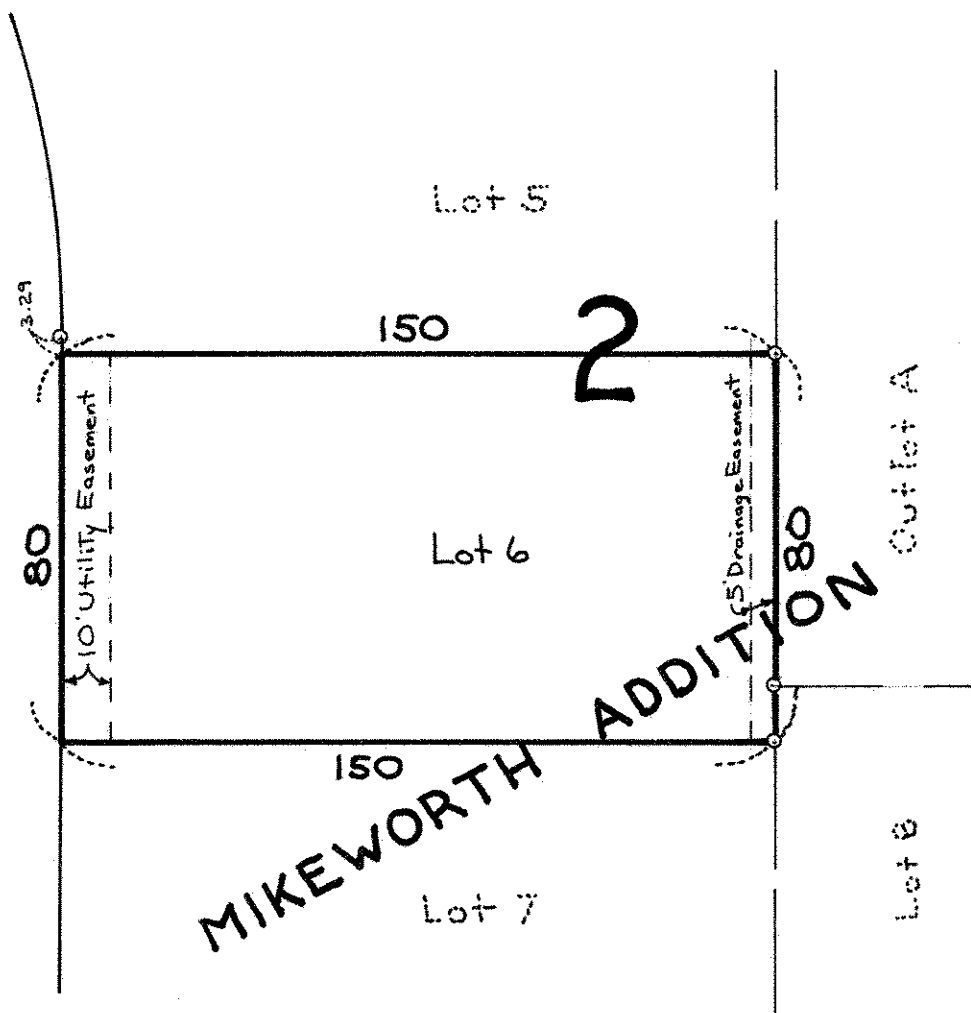

O Denotes Iron Pipe Monument
 Easements as per plat only