NW 36 3022

FROM THE OFFICE OF

CHARLES O. GEORGI COMPANY

2215 West County Road B Saint Paul, Minnesota 55113

REGISTERED CIVIL ENGINEER AND LAND SURVEYOR

Certificate of Survey

I Hereby Certify that this plat shows a survey made by me of the property described on this plat, and that the corners are correctly placed as shown, and that all locations have been correctly shown. Corners not placed to date. Added Corners 9/28/70

Surveyed For Melvin Huber

Date September 1970

Scale 1" = 100'

By Charles O. Georgi
REGISTERED LAND SURVEYOR

Description:
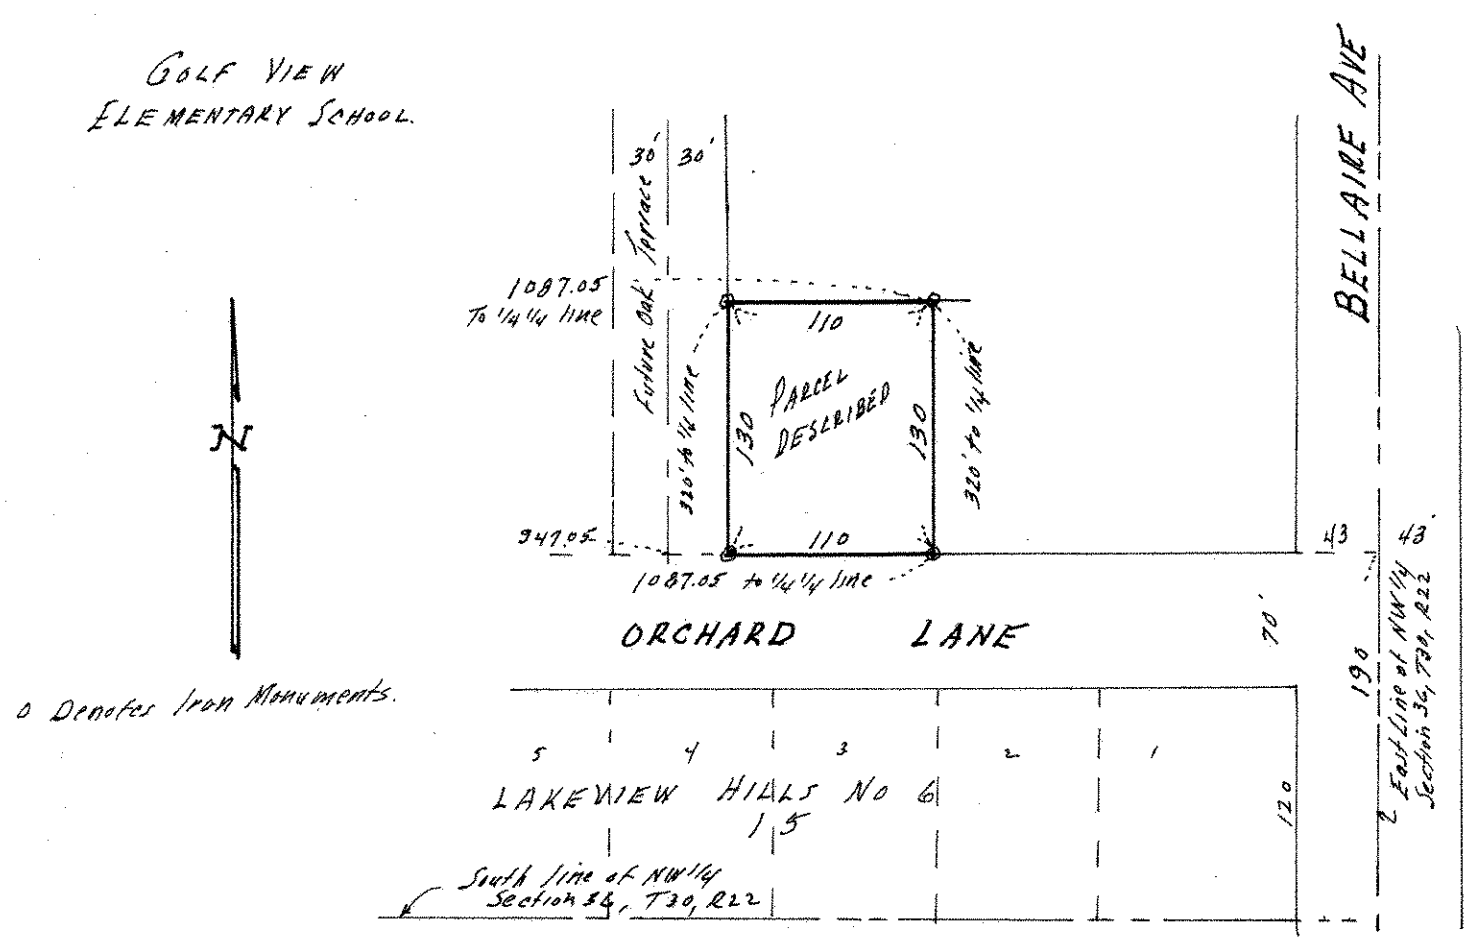
The East 110 feet of the West 1087.05 feet of the North 130 feet of the South 320 feet of the SE 1/4 of the NW 1/4 of Section 36, T30N, R22W. Ramsey County, Minn